
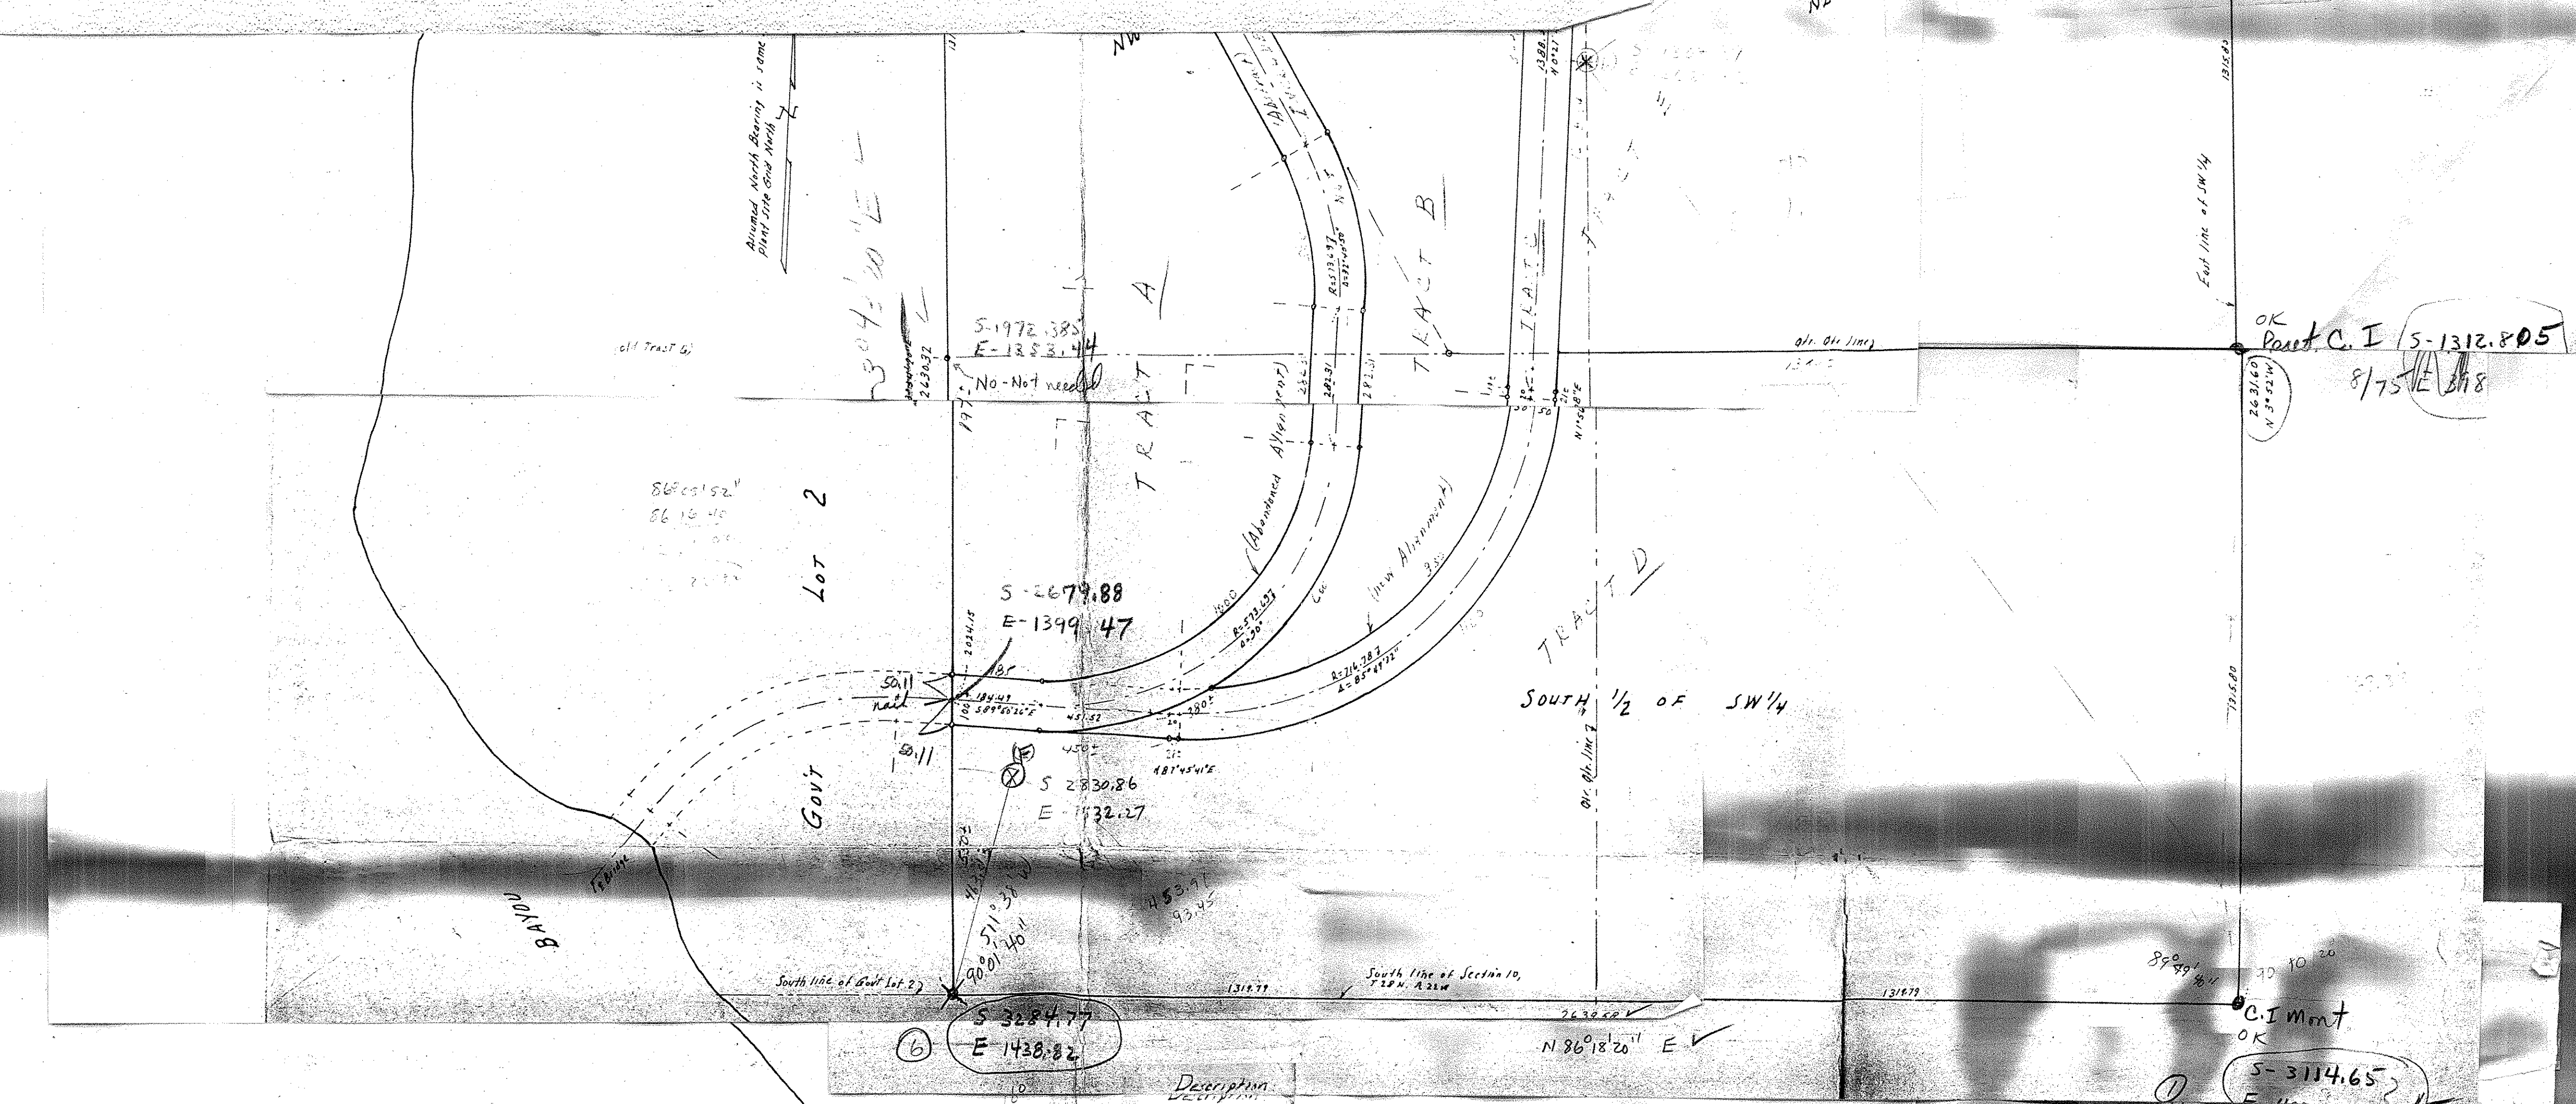


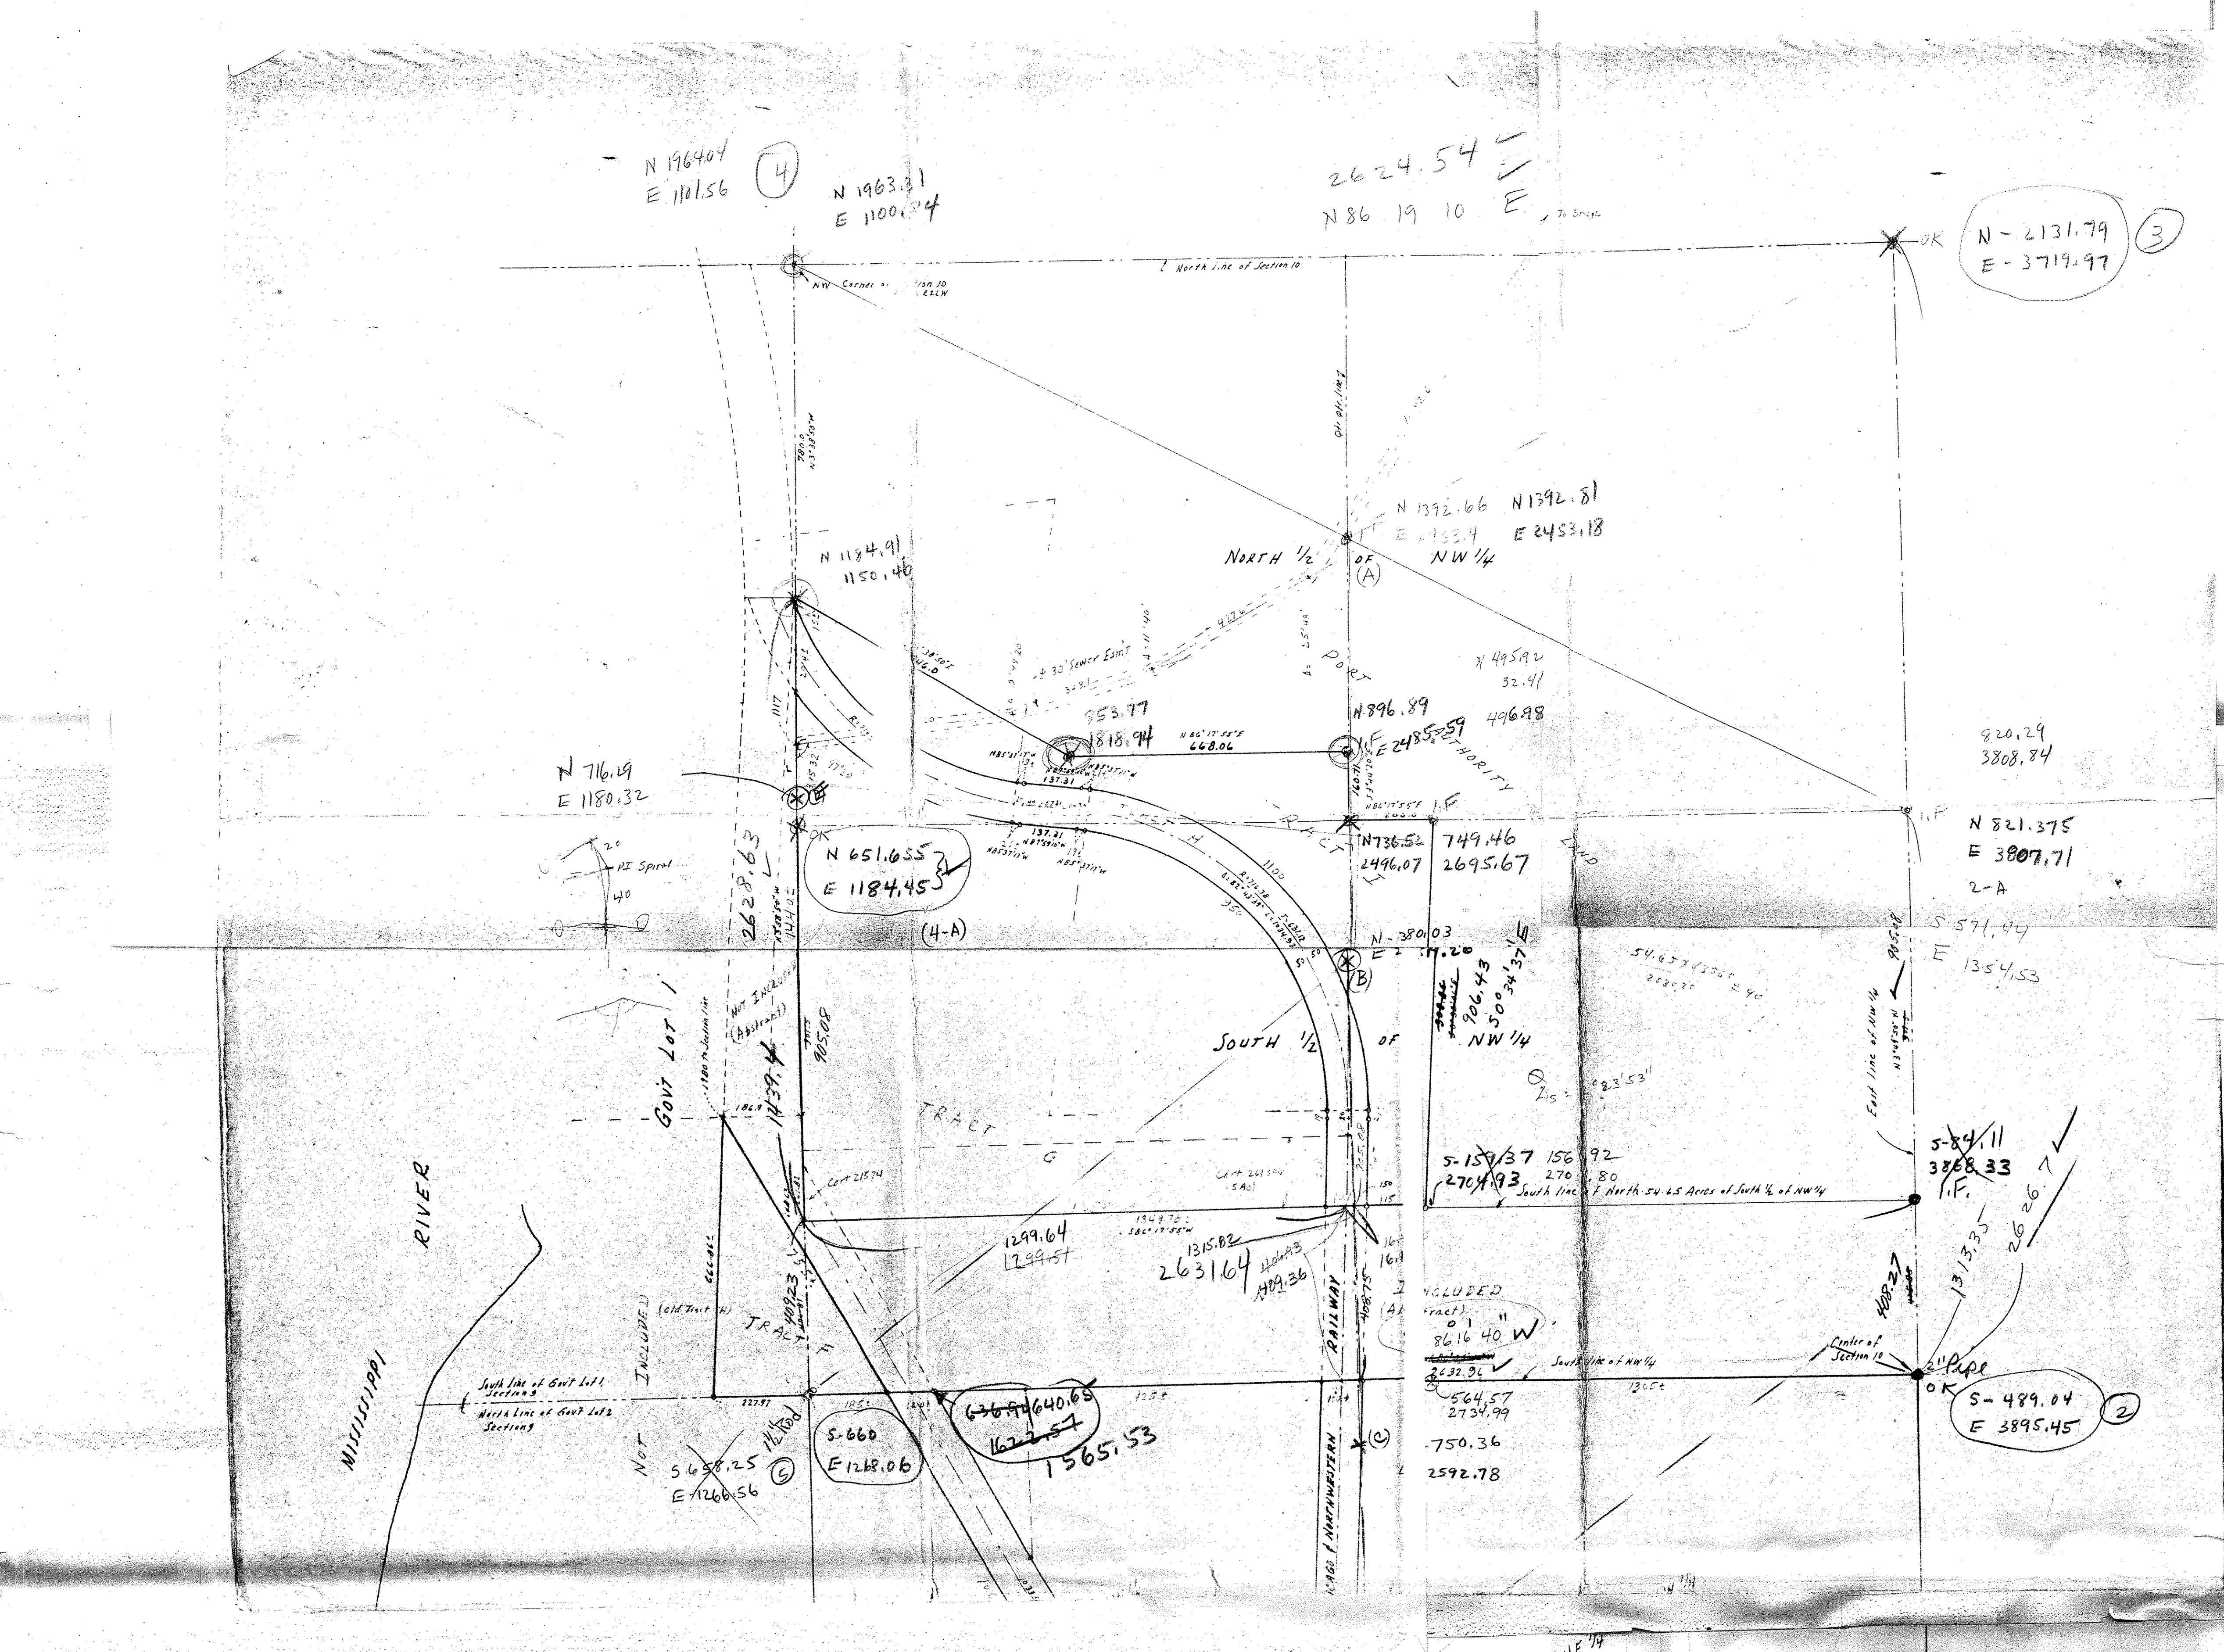

Don't Iron Movement placed at various times within past years

Description

J. R. Hild, Attorney, Dorcy, Marquart, Whelan, McHally & Co. 200-2000 W. 1st St. St. Paul, Minn. 55101

General Note

The area covered by the survey was generally agreed upon by the Attorney and Engineer at St. Paul in order to provide clear title to the Railway across Referred Property, with alignment.

For convenience the entire site is shown hereon, however with Referred Land Surveys for recording being 14"x17", 2 or 3 sheets will be used for the drawing with notes/lines plus additional sheets for the descriptions.

Proposed **REGISTERED LAND SURVEY**
PORTION OF METRO WASTEWATER TREATMENT PLANT
ST. PAUL, MINN.

SCALE 1"= 200'

Brown - Consect Cord -
 Red - Permit Cord -

CHARLES E. SPURILL COMPANY
 CIVIL ENGINEERING & LAND SURVEYING
 3032 N. Lexington Ave.
 St. Paul, Minn. 55105
 651-4455

April 8, 1975
 Charles E. Spurrill, P.E.
 Charles E. Spurrill, P.E. & Associates, Inc.

OK
 S-3114.65
 E-4072.91