

SW 2 28 23

**Certificate
of Survey**

From the office of
GEORGI-SCHMIDT & ASSOC. INC.
3092 No. Lexington Ave., Roseville, Mn. 55113
LAND SURVEYING
483-4408

I Hereby Certify that this plat shows a survey made by me of the property described on this plat, and that the corners are correctly placed as shown, and that all locations have been correctly shown.

Job Number: 281

Surveyed For Brothers Real Estate


Date March 20 1979

Scale 1" = 40'


By Donald W. Schmidt
REGISTERED LAND SURVEYOR

Description:

Lot 20,
Block 22,
Summit Park Addition,
Ramsey County, Minnesota

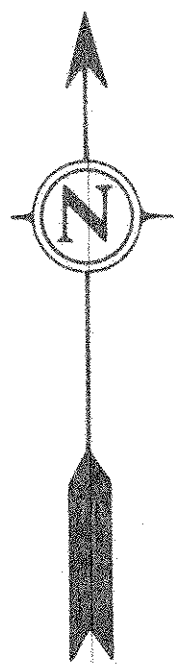

- Denotes Iron Pipe Monument set.
- Denotes Iron Monument found.

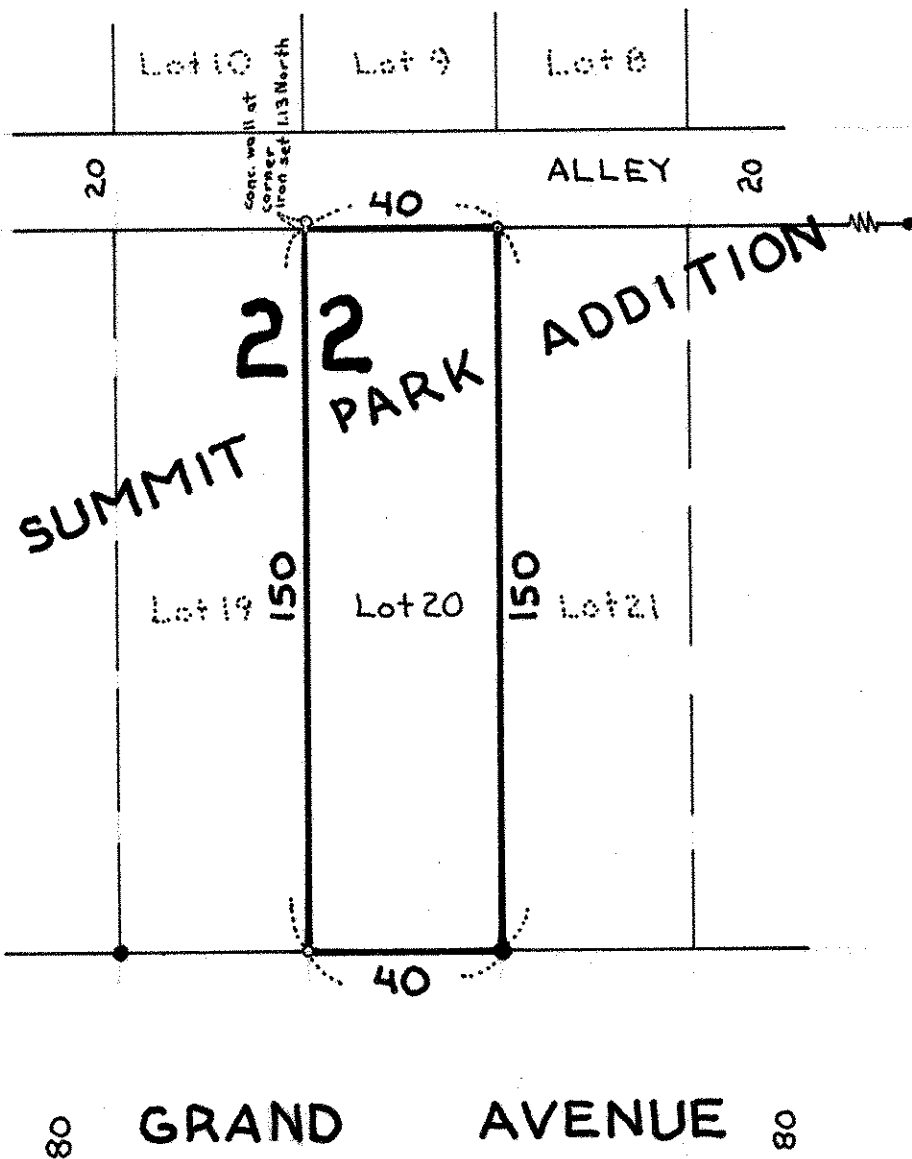

80 GRAND AVENUE 80