

NE 2 28 23

FROM THE OFFICE OF

# CHARLES O. GEORGI COMPANY

2215 West County Road B

Saint Paul, Minnesota 55113

REGISTERED CIVIL ENGINEER AND LAND SURVEYOR

## Certificate of Survey

I Hereby Certify that this plat shows a survey made by me of the property described on this plat, and that the corners are correctly placed as shown, and that all locations have been correctly shown.

Project No. Minn. A-1-1  
Parcel No. 158-A  
Area = 8764 Sq. ft., more or less.

Surveyed For *Housing Authority*


Date *February 1973*

Scale *1" = 40'*

By *Charles O. Georgi*  
REGISTERED LAND SURVEYOR

### Description:

*Lots 1 and 2, Block 8  
Holcomb's Addition to St. Paul  
Ramsey County, Minn.*

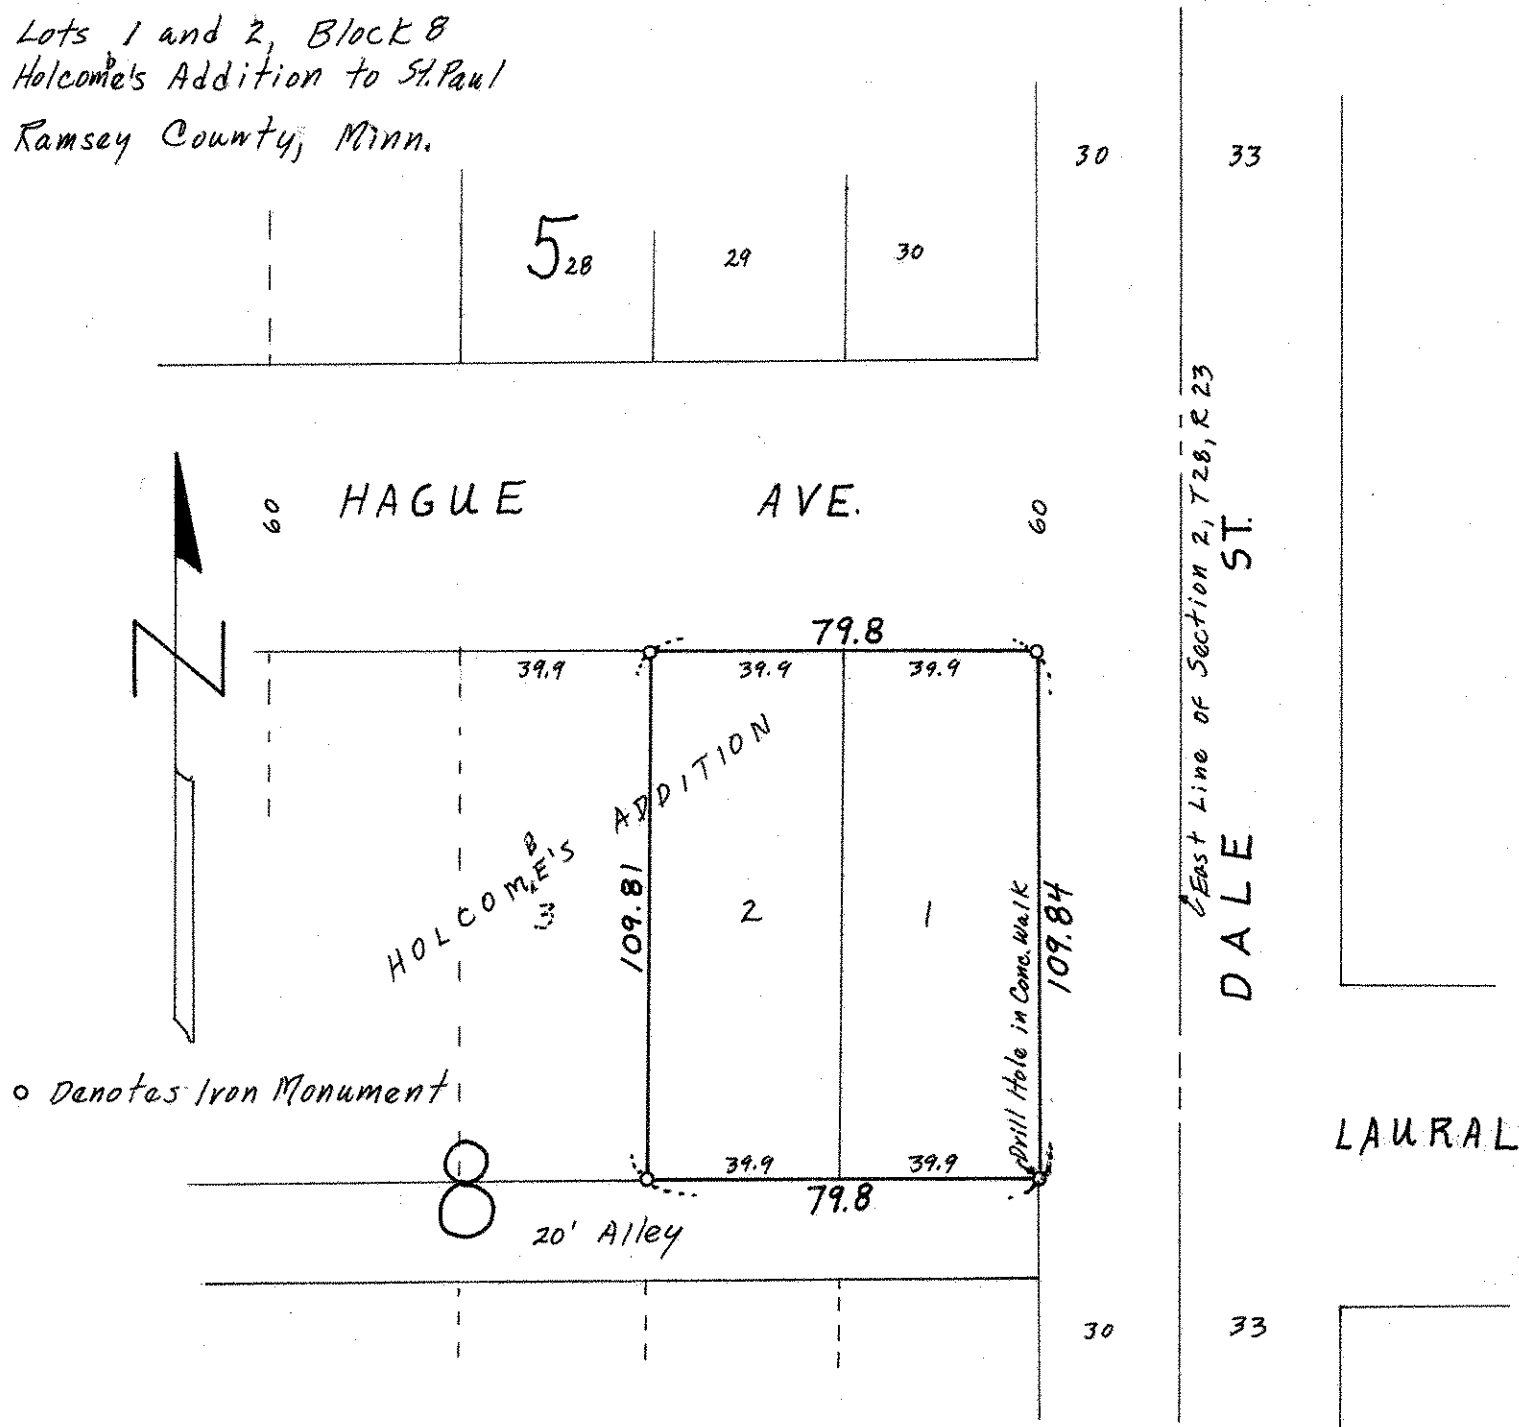

o Denotes Iron Monument