FROM THE OFFICE OF

Certificate of Survey

Project No. Minn. A-1-1 Parcel No. 23-B Area. 7,258 sq.ft.m.al.

33

CHARLES O. GEORGI COMPANY

2215 West County Road B


Saint Paul, Minnesota 55113

REGISTERED CIVIL ENGINEER AND LAND SURVEYOR

I Hereby Certify that this plat shows a survey made by me of the property described on this plat, and that the corners are correctly placed as shown, and that all locations have been correctly shown.

Surveyed For Housing Authority Date May 1973 Scale /"-30'

Description: Lot 16 and the West 18.54 feet of lot 17, Block 2, Mackubin and Marshall's addition to St. Paul, Ramsey County, Minnesota.

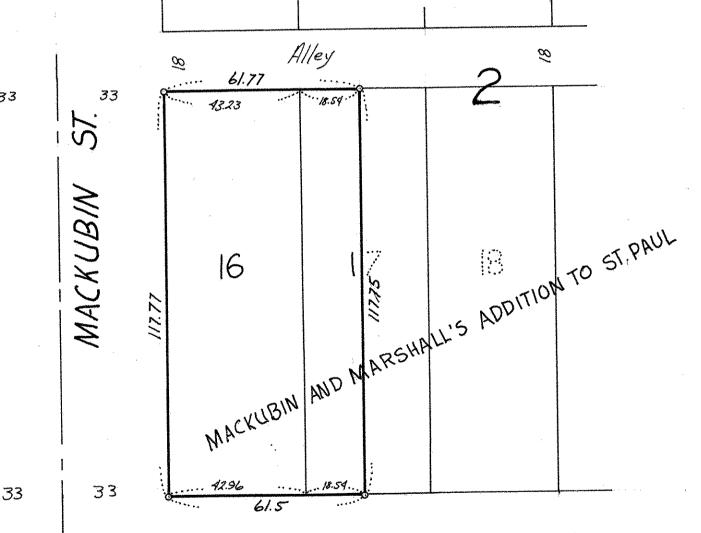

AVE. AURORA