FROM THE OFFICE OF

Gertificate of Survey

Project No Minn A-1-1

Parcel No. 131-C Aera 3,516 sq.ft. m.o.l. Description:

CHARLES O. GEORGI COMPANY

2215 West County Road B

Saint Paul, Minnesota 55113


REGISTERED CIVIL ENGINEER AND LAND SURVEYOR

I Hereby Certify that this plat shows a survey made by me of the property described on this plat, and that the corners are correctly placed as shown, and that all locations have been correctly shown.

Surveyed For Housing Authority

Date September 1923 Scale / "= 40

Lot 16, "Selby Block St. Paul, Minnesota being Autitor's Subdivision No. 5", Ramsey County, Minnesota.

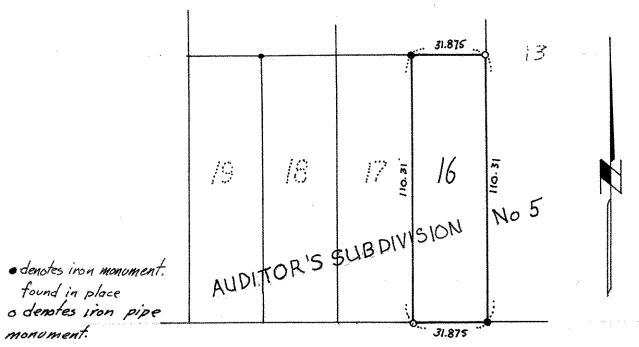

SELBY AVE.