NE 1 28 23

FROM THE OFFICE OF

CHARLES O. GEORGI COMPANY

2215 West County Road B Saint Paul, Minnesota 55113

REGISTERED CIVIL ENGINEER AND LAND SURVEYOR

Certificate of Survey

Project No. Minn A-1-1
Parcel No. 102-A
Area, 4,181. sq.ft. m.o.l.

I Hereby Certify that this plat shows a survey made by me of the property described on this plat, and that the corners are correctly placed as shown, and that all locations have been correctly shown.

Surveyed For Housing Authority
Date September 1973
Scale 1"=40'

By Charles O. Georgi
REGISTERED LAND SURVEYOR

Description:
West ½ of Lot 2, Block 80, Dayton and Irvine's Addition to St. Paul, Ramsey County, Minnesota.

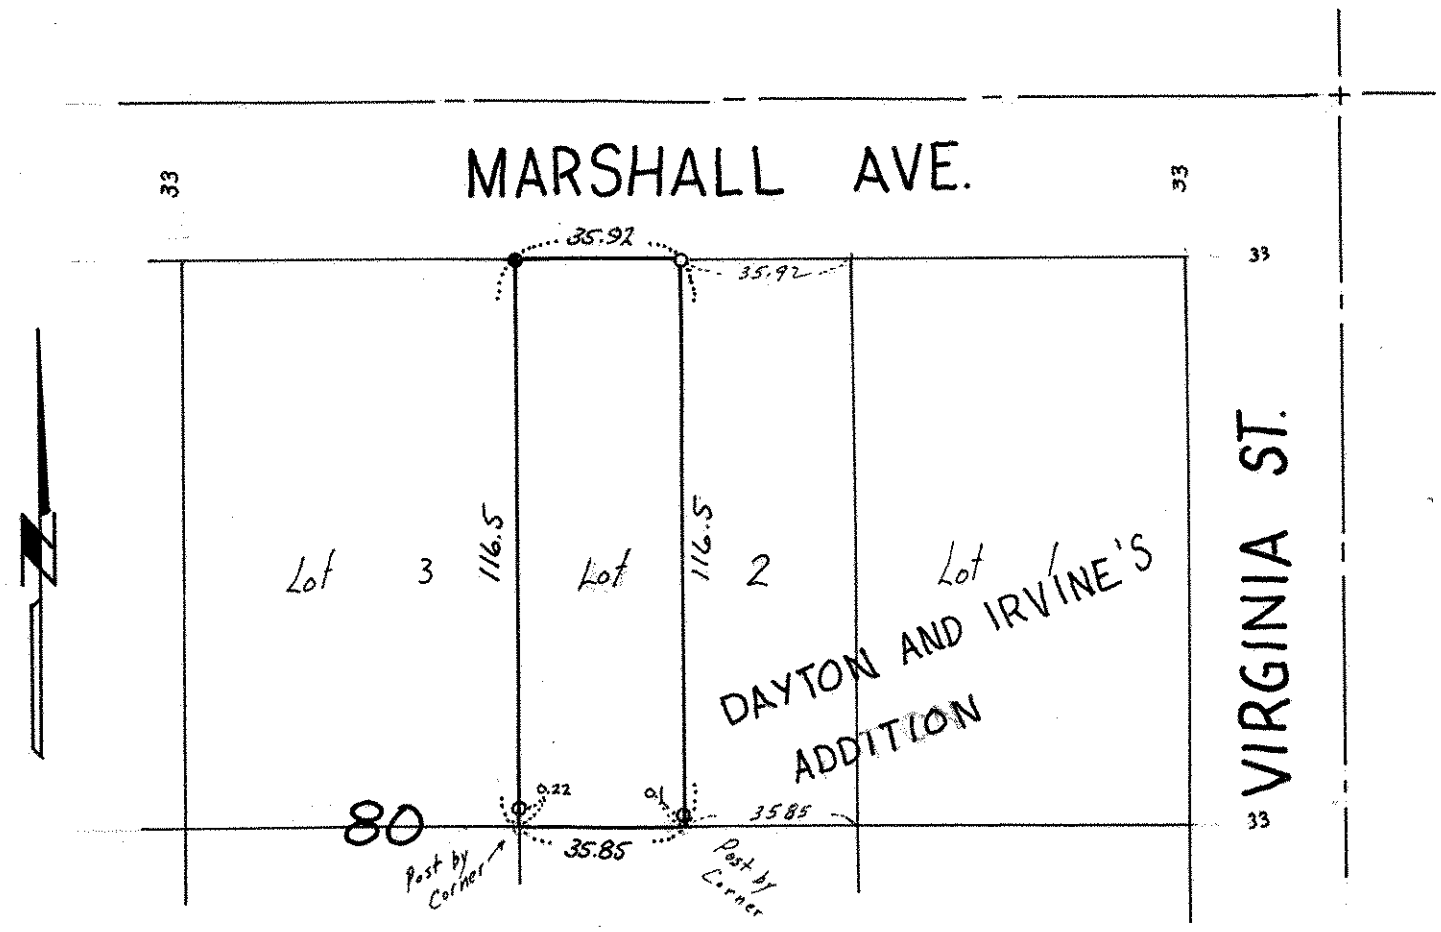

o denotes iron pipe monuments
• denotes iron pipe monument found in place.