NE 11 28 23

FROM THE OFFICE OF

CHARLES O. GEORGI COMPANY

2215 West County Road B Saint Paul, Minnesota 55113

REGISTERED CIVIL ENGINEER AND LAND SURVEYOR

Certificate of Survey

Project No. Minn A-1-7
Parcel No. 139-A
Area: 5645 Sq. Ft., m.o.l.

I Hereby Certify that this plat shows a survey made by me of the property described on this plat, and that the corners are correctly placed as shown, and that all locations have been correctly shown.

Surveyed For Housing Authority

Date August 1973

Scale 1" = 40'

By Charles O. Georgi
REGISTERED LAND SURVEYOR
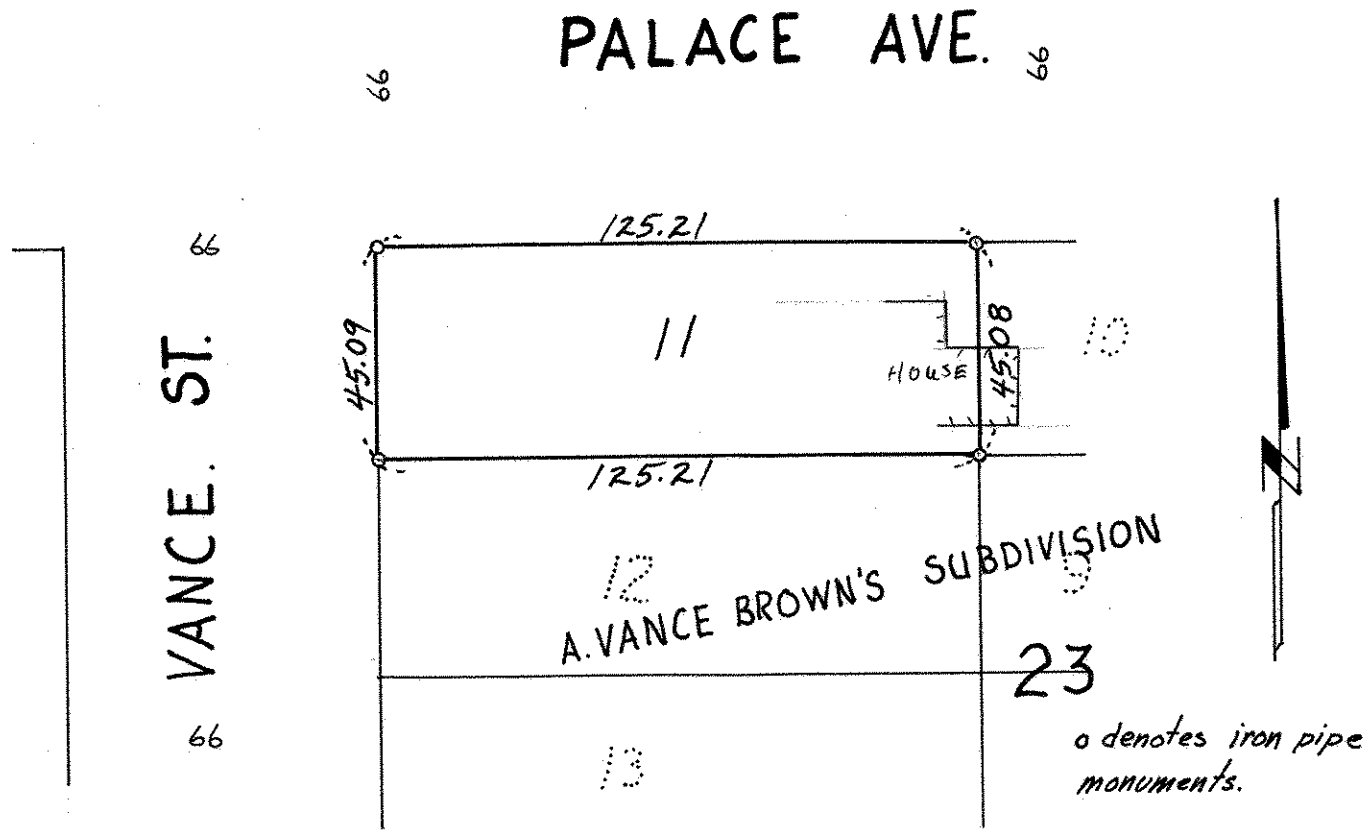
Description:
Lot 11, Block 23, A. Vance Brown's Subdivision of "Stinson, Brown and Ramsey's" Addition to St. Paul, Ramsey County, Minnesota.