FROM THE OFFICE OF

Certificate

of Survey

Project No. Minn. A-1-7 Parcel No. 147.B Area. 5,077 sq.ft. m.o.l. CHARLES O. GEORGI COMPANY

2215 West County Road B

Saint Paul, Minnesota 55113

REGISTERED CIVIL ENGINEER AND LAND SURVEYOR

I Hereby Certify that this plat shows a survey made by me of the property described on this plat, and that the corners are correctly placed as shown, and that all locations have been correctly shown.

Surveyed For Housing Authority


Date March 1973

Name Of Surveyor

Description:

Lot 24, Block 2, Michel and Robertson's

Addition, Ramsey County, Minnesota.

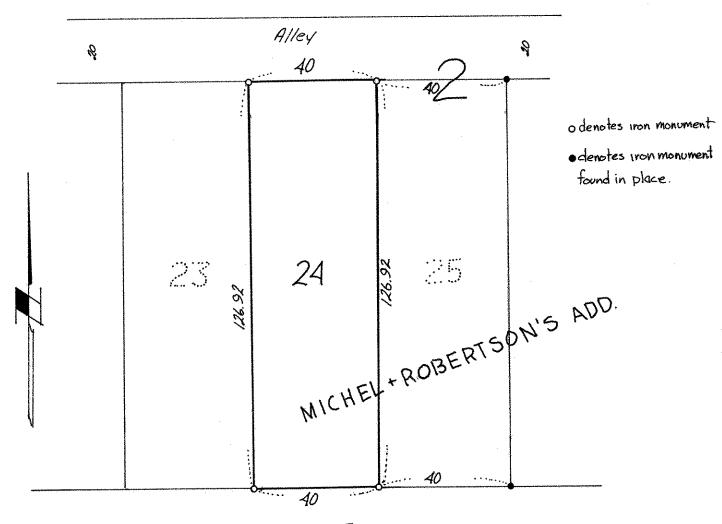

R PALACE AVE.

8