

SE 11, 28, 23

FROM THE OFFICE OF

CHARLES O. GEORGI COMPANY

2215 West County Road B

Saint Paul, Minnesota 55113

REGISTERED CIVIL ENGINEER AND LAND SURVEYOR

Certificate of Survey

I Hereby Certify that this plat shows a survey made by me of the property described on this plat, and that the corners are correctly placed as shown, and that all locations have been correctly shown.

Project No. Minn A-1-7
Parcel No 208-A
Area. 5097 sq ft. m.o.

Surveyed For *Housing Authority*


Date *May 1973*

Scale *1"=40'*

By *Charles O. Georgi*
REGISTERED LAND SURVEYOR

Description:

*Lot 7, of the Rearrangement of Block 10,
Clark's Addition to the City of St. Paul, Ramsey
County, Minnesota.*

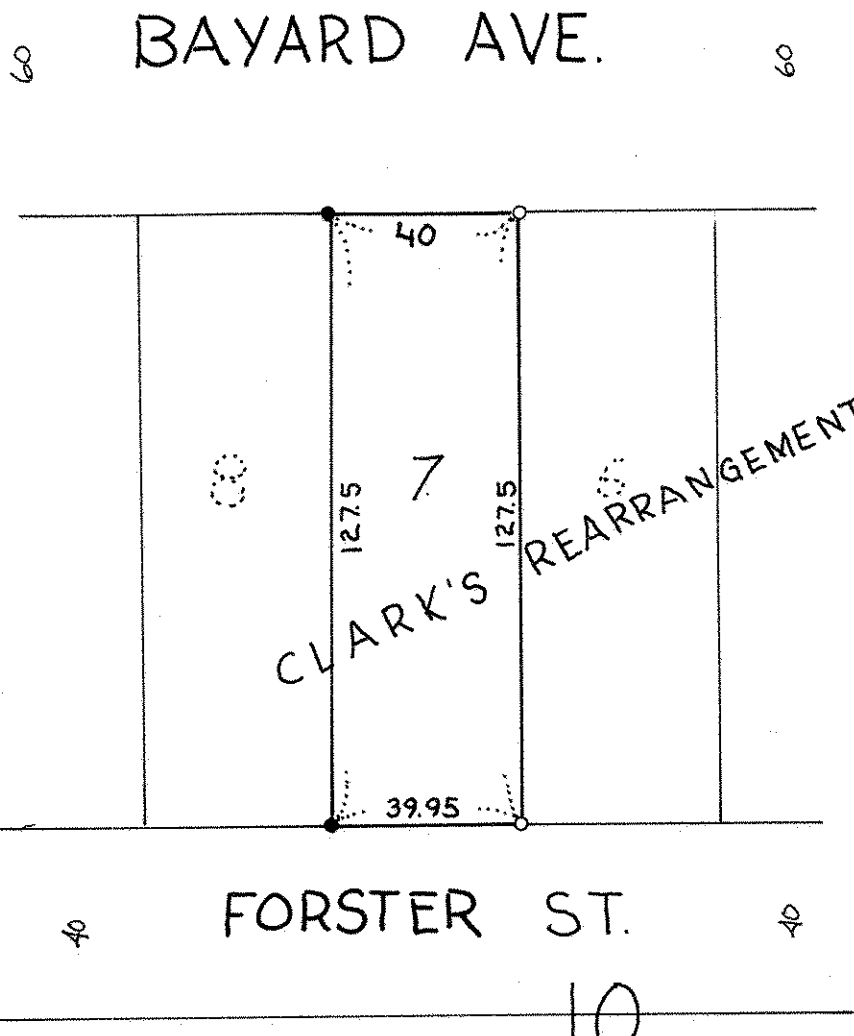

- o denotes iron pipe monument.
- denotes iron pipe monument found in place