

FROM THE OFFICE OF

# CHARLES O. GEORGI COMPANY

2215 West County Road B

Saint Paul, Minnesota 55113

REGISTERED CIVIL ENGINEER AND LAND SURVEYOR

**Certificate  
of Survey**

Project No. Minn A-1-1  
Parcel No. 160-G  
Area. 7,154 sq.ft. m.o.l.

*I Hereby Certify that this plat shows a survey made by me of the property described on this plat, and that the corners are correctly placed as shown, and that all locations have been correctly shown.*

**Surveyed For** *Housing Authority*


**Date** *January 1977*

**Scale** *1" = 40'*

By *Donald W. Schmiel*  
REGISTERED LAND SURVEYOR

**Description:**

Lot 20, Block 8,  
Woodland Park Addition,  
Ramsey County, Minnesota.

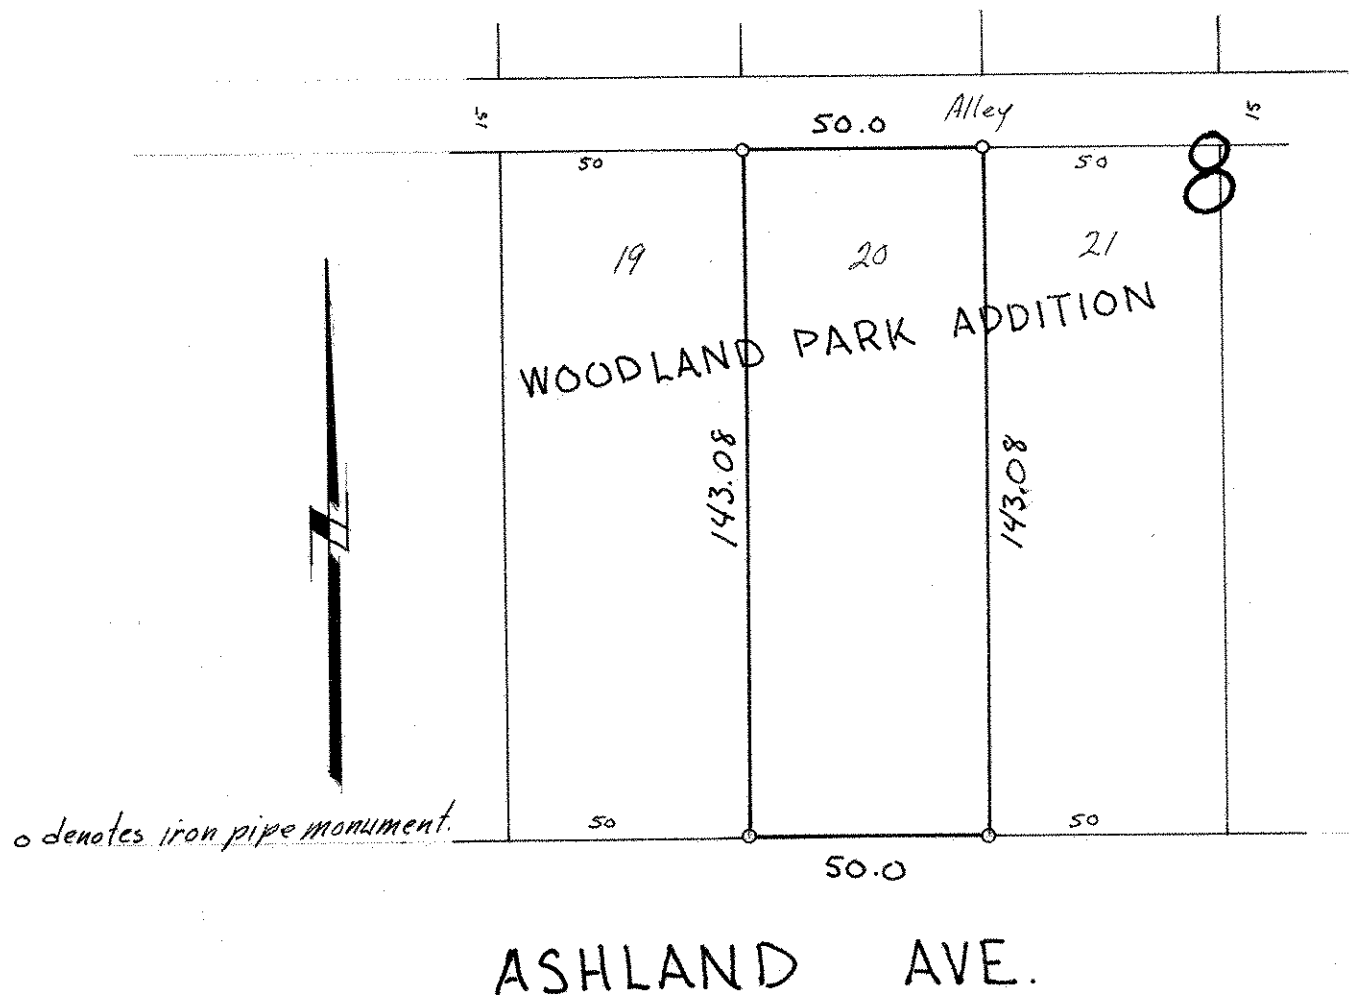

*o denotes iron pipe monument.*