

FROM THE OFFICE OF

CHARLES O. GEORGI COMPANY

2215 West County Road B

Saint Paul, Minnesota 55113

REGISTERED CIVIL ENGINEER AND LAND SURVEYOR

**Certificate
of Survey**

I Hereby Certify that this plat shows a survey made by me of the property described on this plat, and that the corners are correctly placed as shown, and that all locations have been correctly shown.

Project No. Minn A-1-1
Parcel No 105-A
Area 6,779 sq.ft. m.o.l.

Surveyed For Housing Authority


Date February 1977

Scale 1" = 40'

By Charles O. Georgi
REGISTERED LAND SURVEYOR

Description:

Lot 16 except the Easterly 10.0 feet thereof, Block 1,
Woodland Park Addition,
Ramsey County, Minnesota.

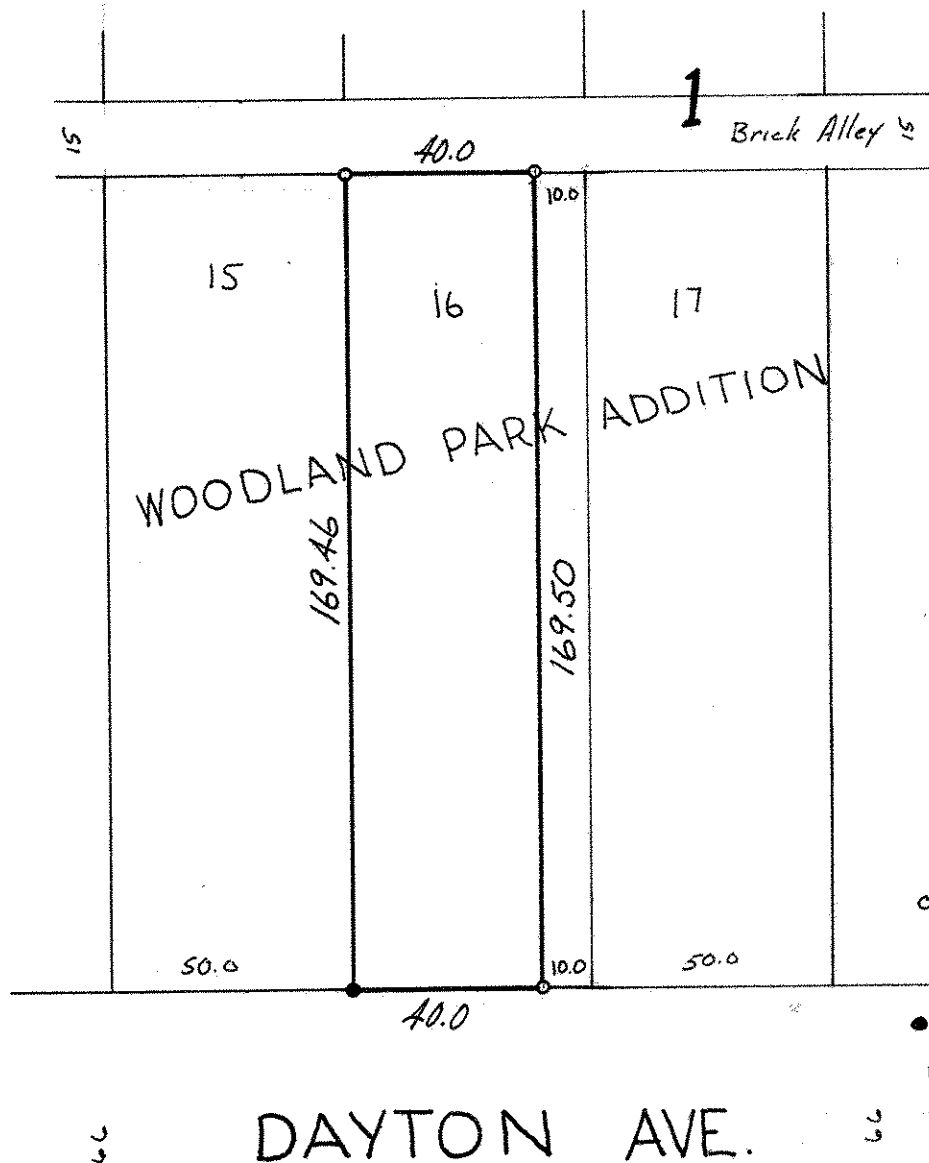

o denotes iron pipe monument.

● denotes iron pipe monuments found in place