FROM THE OFFICE OF

Gertificate of Survey

Project No Minn A-1-1

Parce | No 105-A-1

Area 18,652 sq ff m.o.l.

Description:

CHARLES O. GEORGI COMPANY

2215 West County Road B

Saint Paul, Minnesota 55113


REGISTERED CIVIL ENGINEER AND LAND SURVEYOR

I Hereby Certify that this plat shows a survey made by me of the property described on this plat, and that the corners are correctly placed as shown, and that all locations have been correctly shown.

Surveyed For Housing Huthority
Date February 1977

RECEITERED LAND SURVEYOR

The Easterly 10.0 feet of lot 16, lot: 17 and lot 18, Block 1, Wood land Park Addition.
Ramsey County, Minnesota.

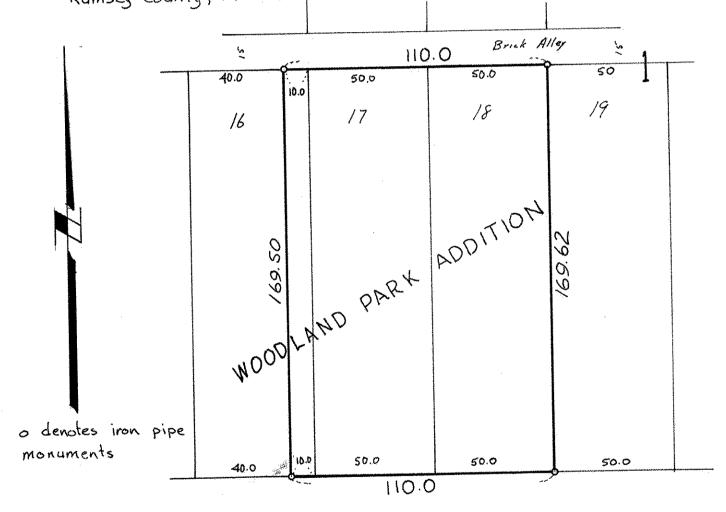

DAYTON AVE.