
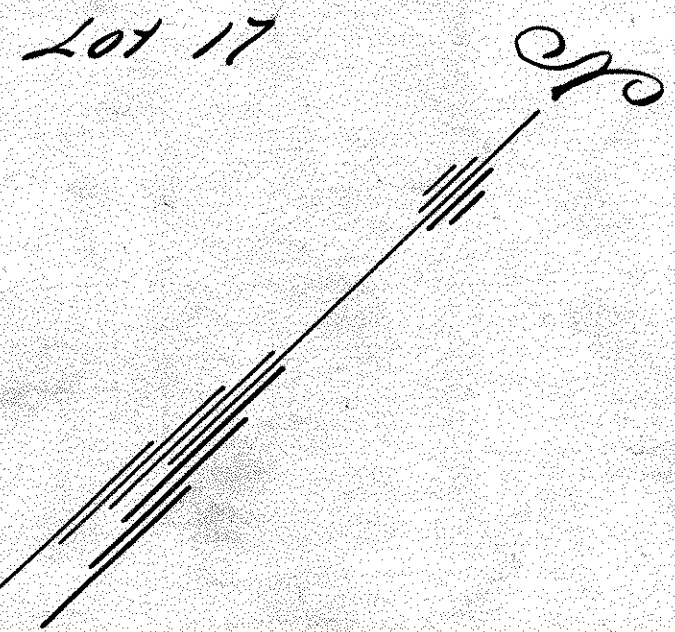


BLOCK 1
 LOT 16, ASYLUM ADD. NO. 1.

Surveyed By JOHN B. IRVINE Dec. 12th 1902 For FRANK REHEISEN

Scale 10. Feet pt. inch.

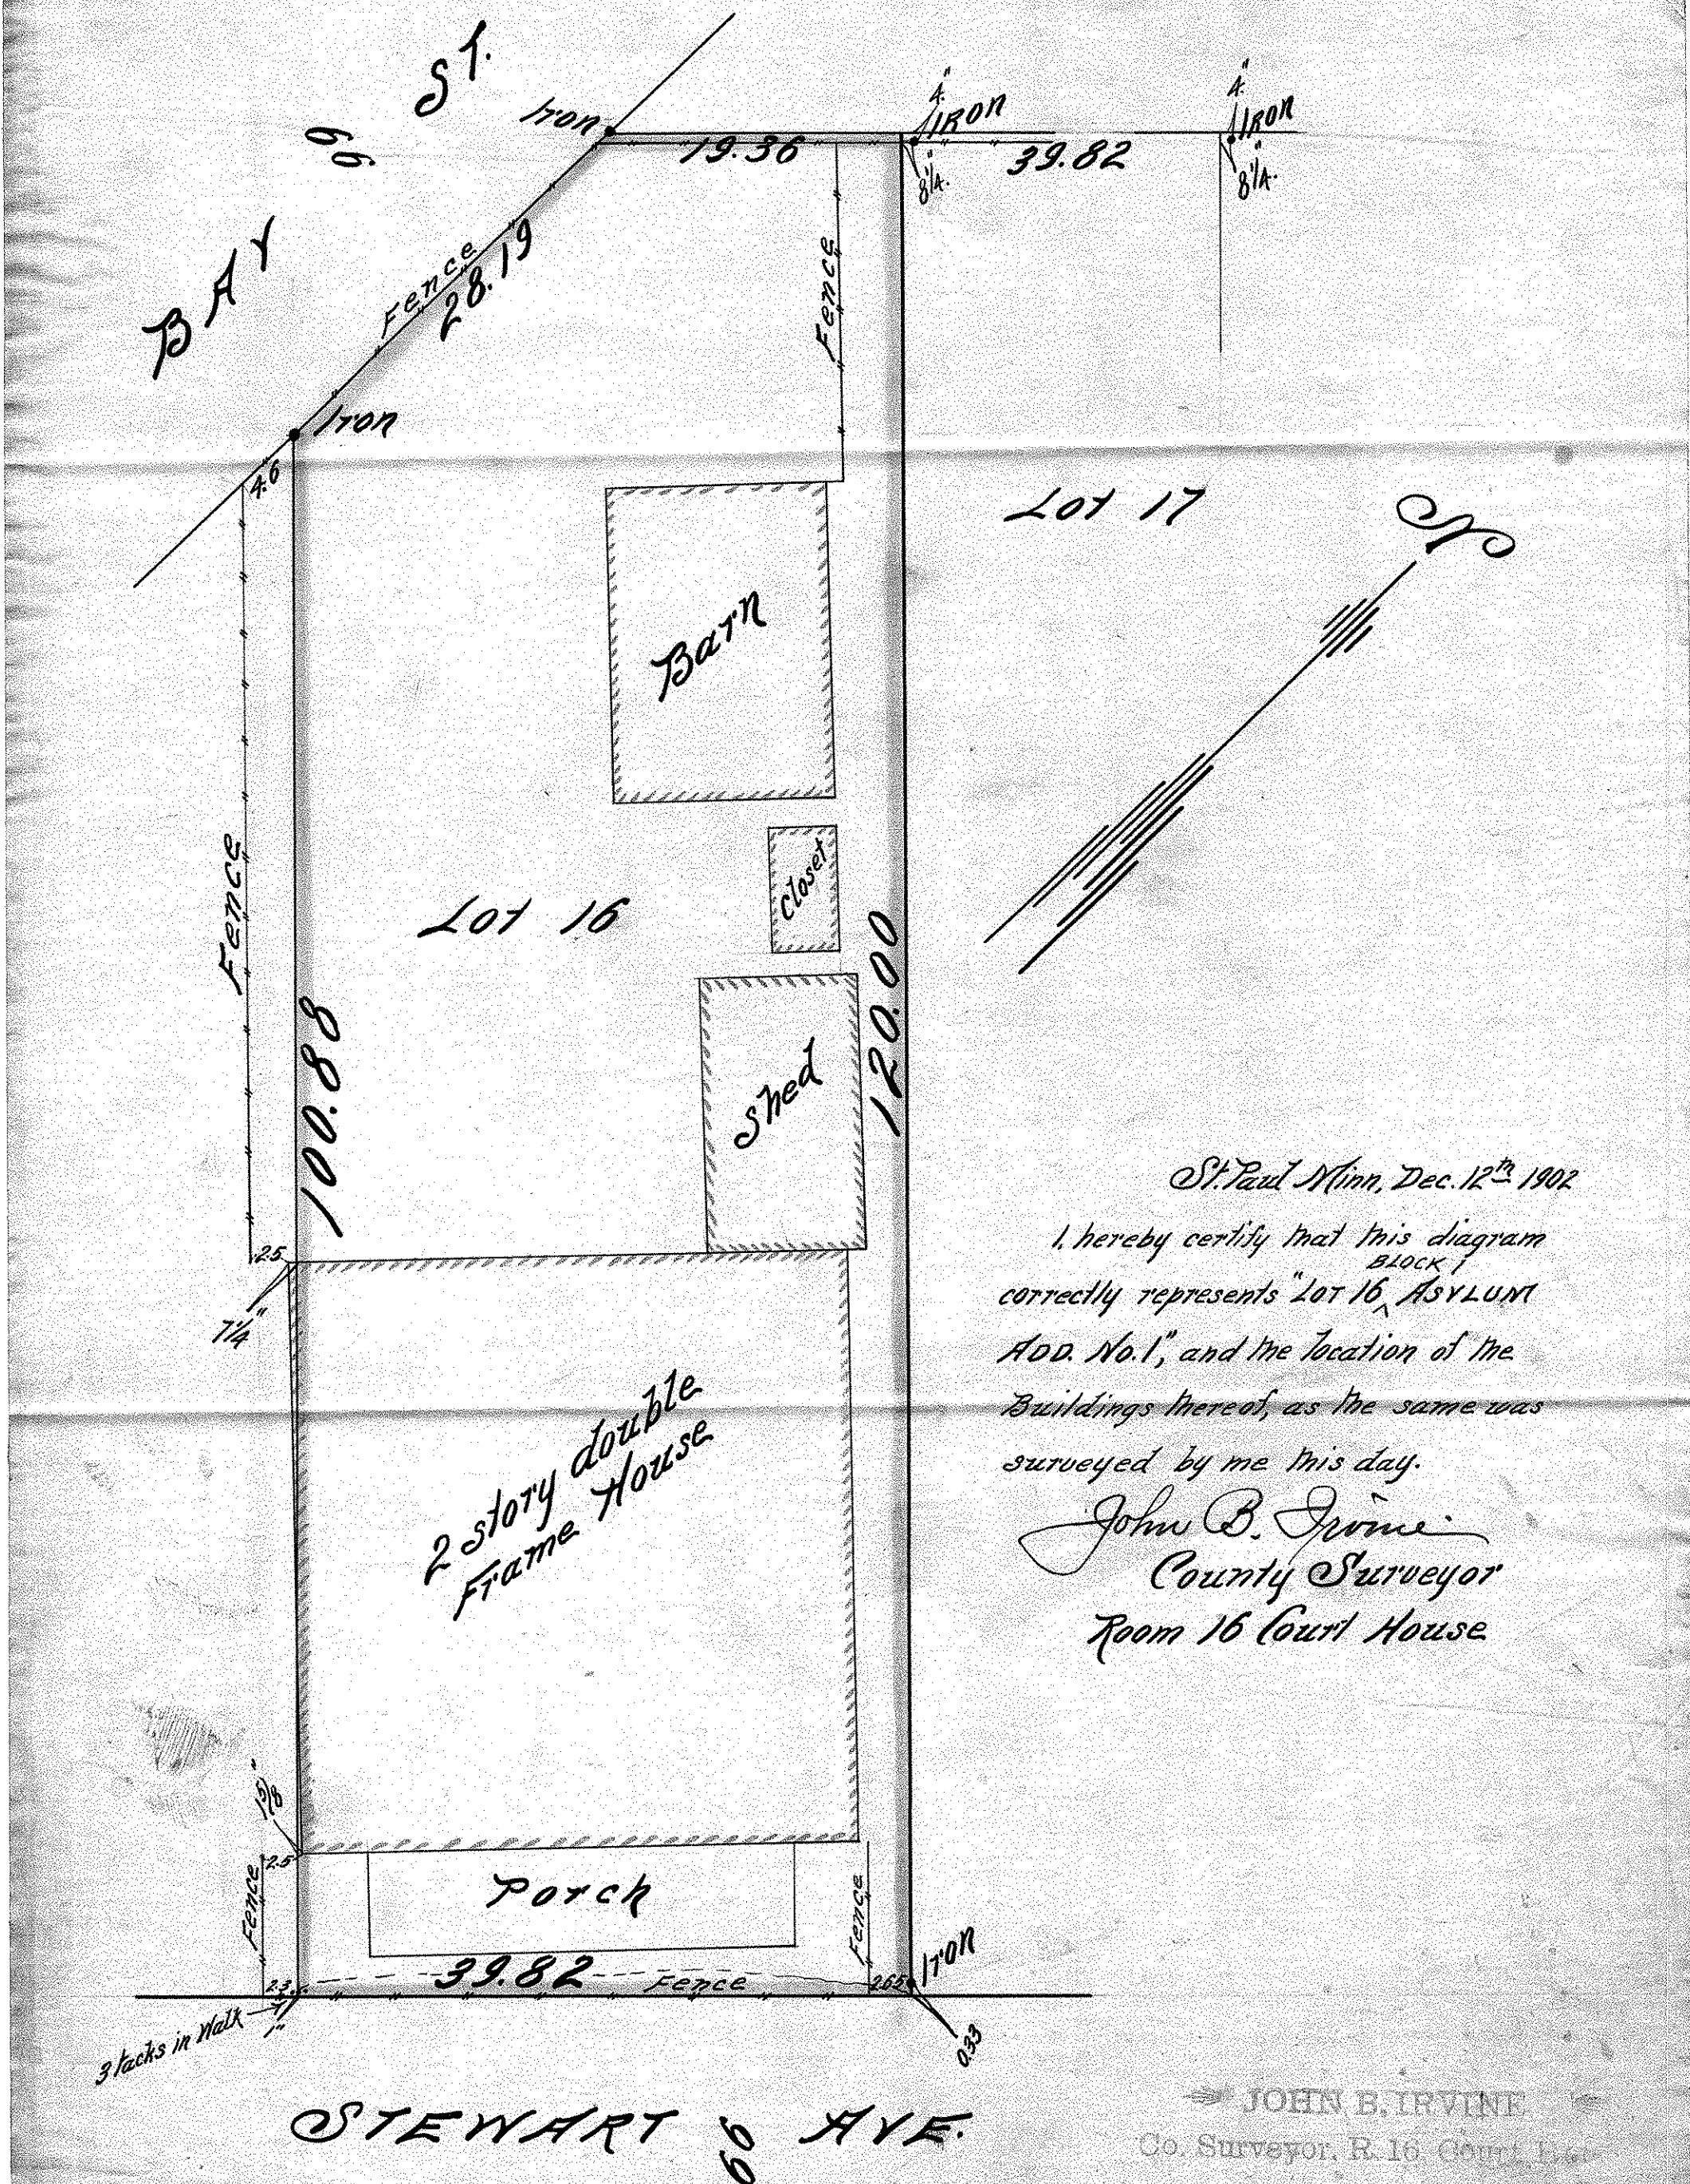

St. Paul Minn. Dec. 12th 1902
 I hereby certify that this diagram
 correctly represents "LOT 16, ASYLUM
 ADD. NO. 1", and the location of the
 buildings thereof, as the same was
 surveyed by me this day.
 John B. Irvine
 County Surveyor
 Room 16 Court House

STEWART ST. AVE.

JOHN B. IRVINE
 Co. Surveyor, R. 16. Court House

B. 53, P. 42