SE 11-28-23

FROM THE OFFICE OF

CHARLES O. GEORGI COMPANY

2215 West County Road B — Saint Paul, Minnesota 55113

REGISTERED CIVIL ENGINEER AND LAND SURVEYOR

Certificate of Survey

Project No. Minn. A-1-7
Parcel No 213:A
Area. 5,470 sq.ft. m.o.l

I Hereby Certify that this plat shows a survey made by me of the property described on this plat, and that the corners are correctly placed as shown, and that all locations have been correctly shown.

Surveyed For Housing Authority
Date April 1974
Scale 1" = 40'

By Charles O. Georgi
REGISTERED LAND SURVEYOR

Description:

Lot 17, Block 3,
Asylum Addition No. 2
to the City of St. Paul,
Ramsey County, Minnesota.

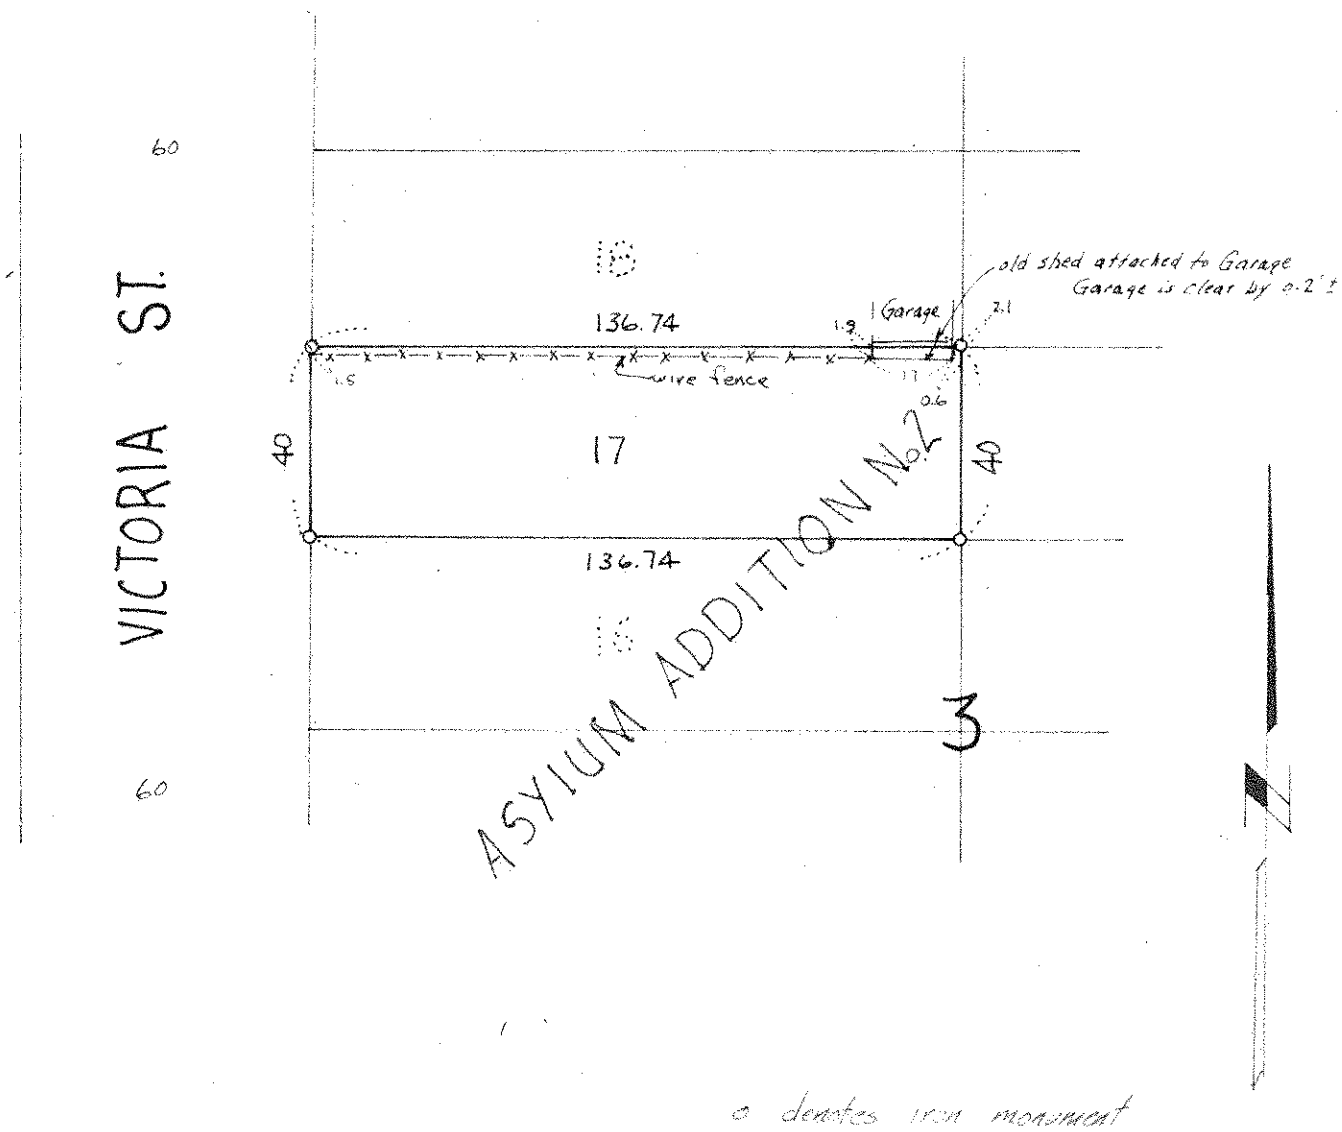

o denotes iron monument