NE 2 28 23

Certificate of Survey

From the office of

GEORGI- SCHMIDT & ASSOC. INC.

3092 No. Lexington Ave., Roseville, Mn. 55113

LAND SURVEYING

483-4408

I Hereby Certify that this plat shows a survey made by me of the property described on this plat, and that the corners are correctly placed as shown, and that all locations have been correctly shown.

Job Number: 661

Surveyed For Peter Quinn

Date 6/11/80

Scale 1"=30'

By Donald W. Schmidt
REGISTERED LAND SURVEYOR

Description:

Lot 25, Block 9, Holcombe's Addition to St. Paul
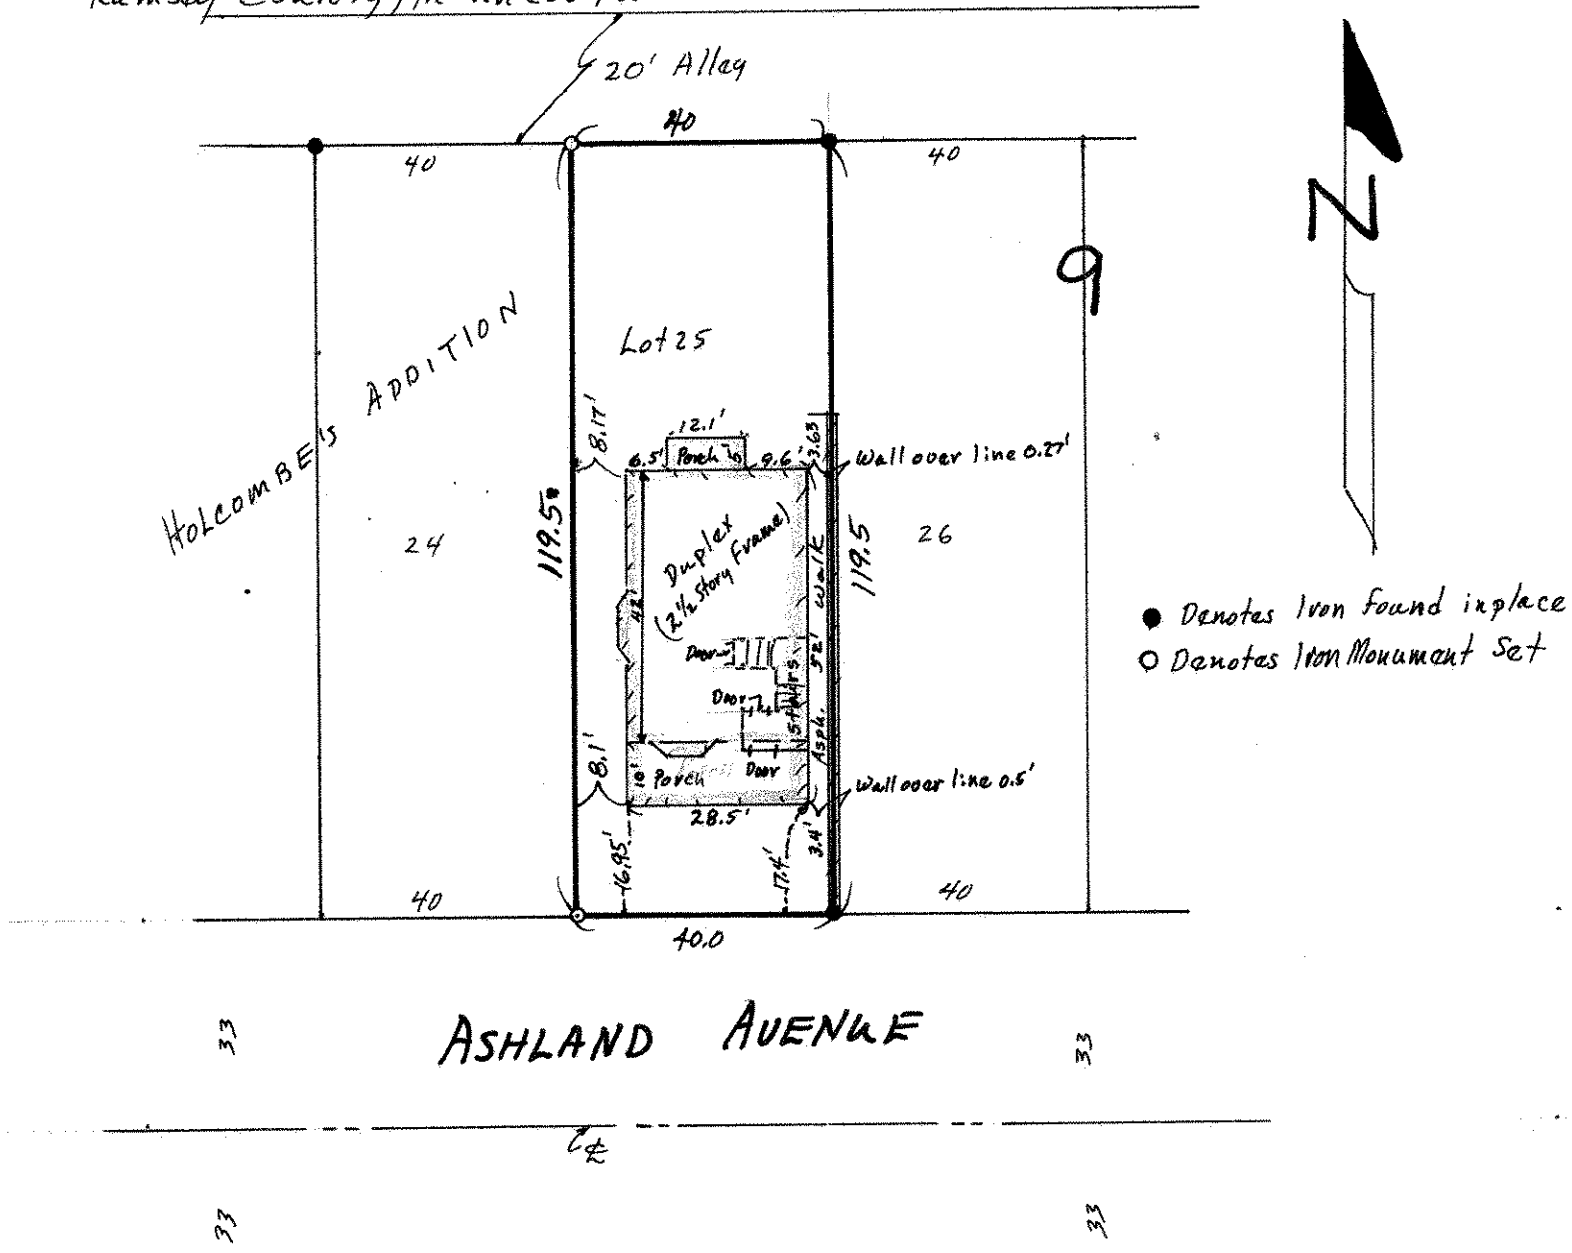
Ramsey County, Minnesota