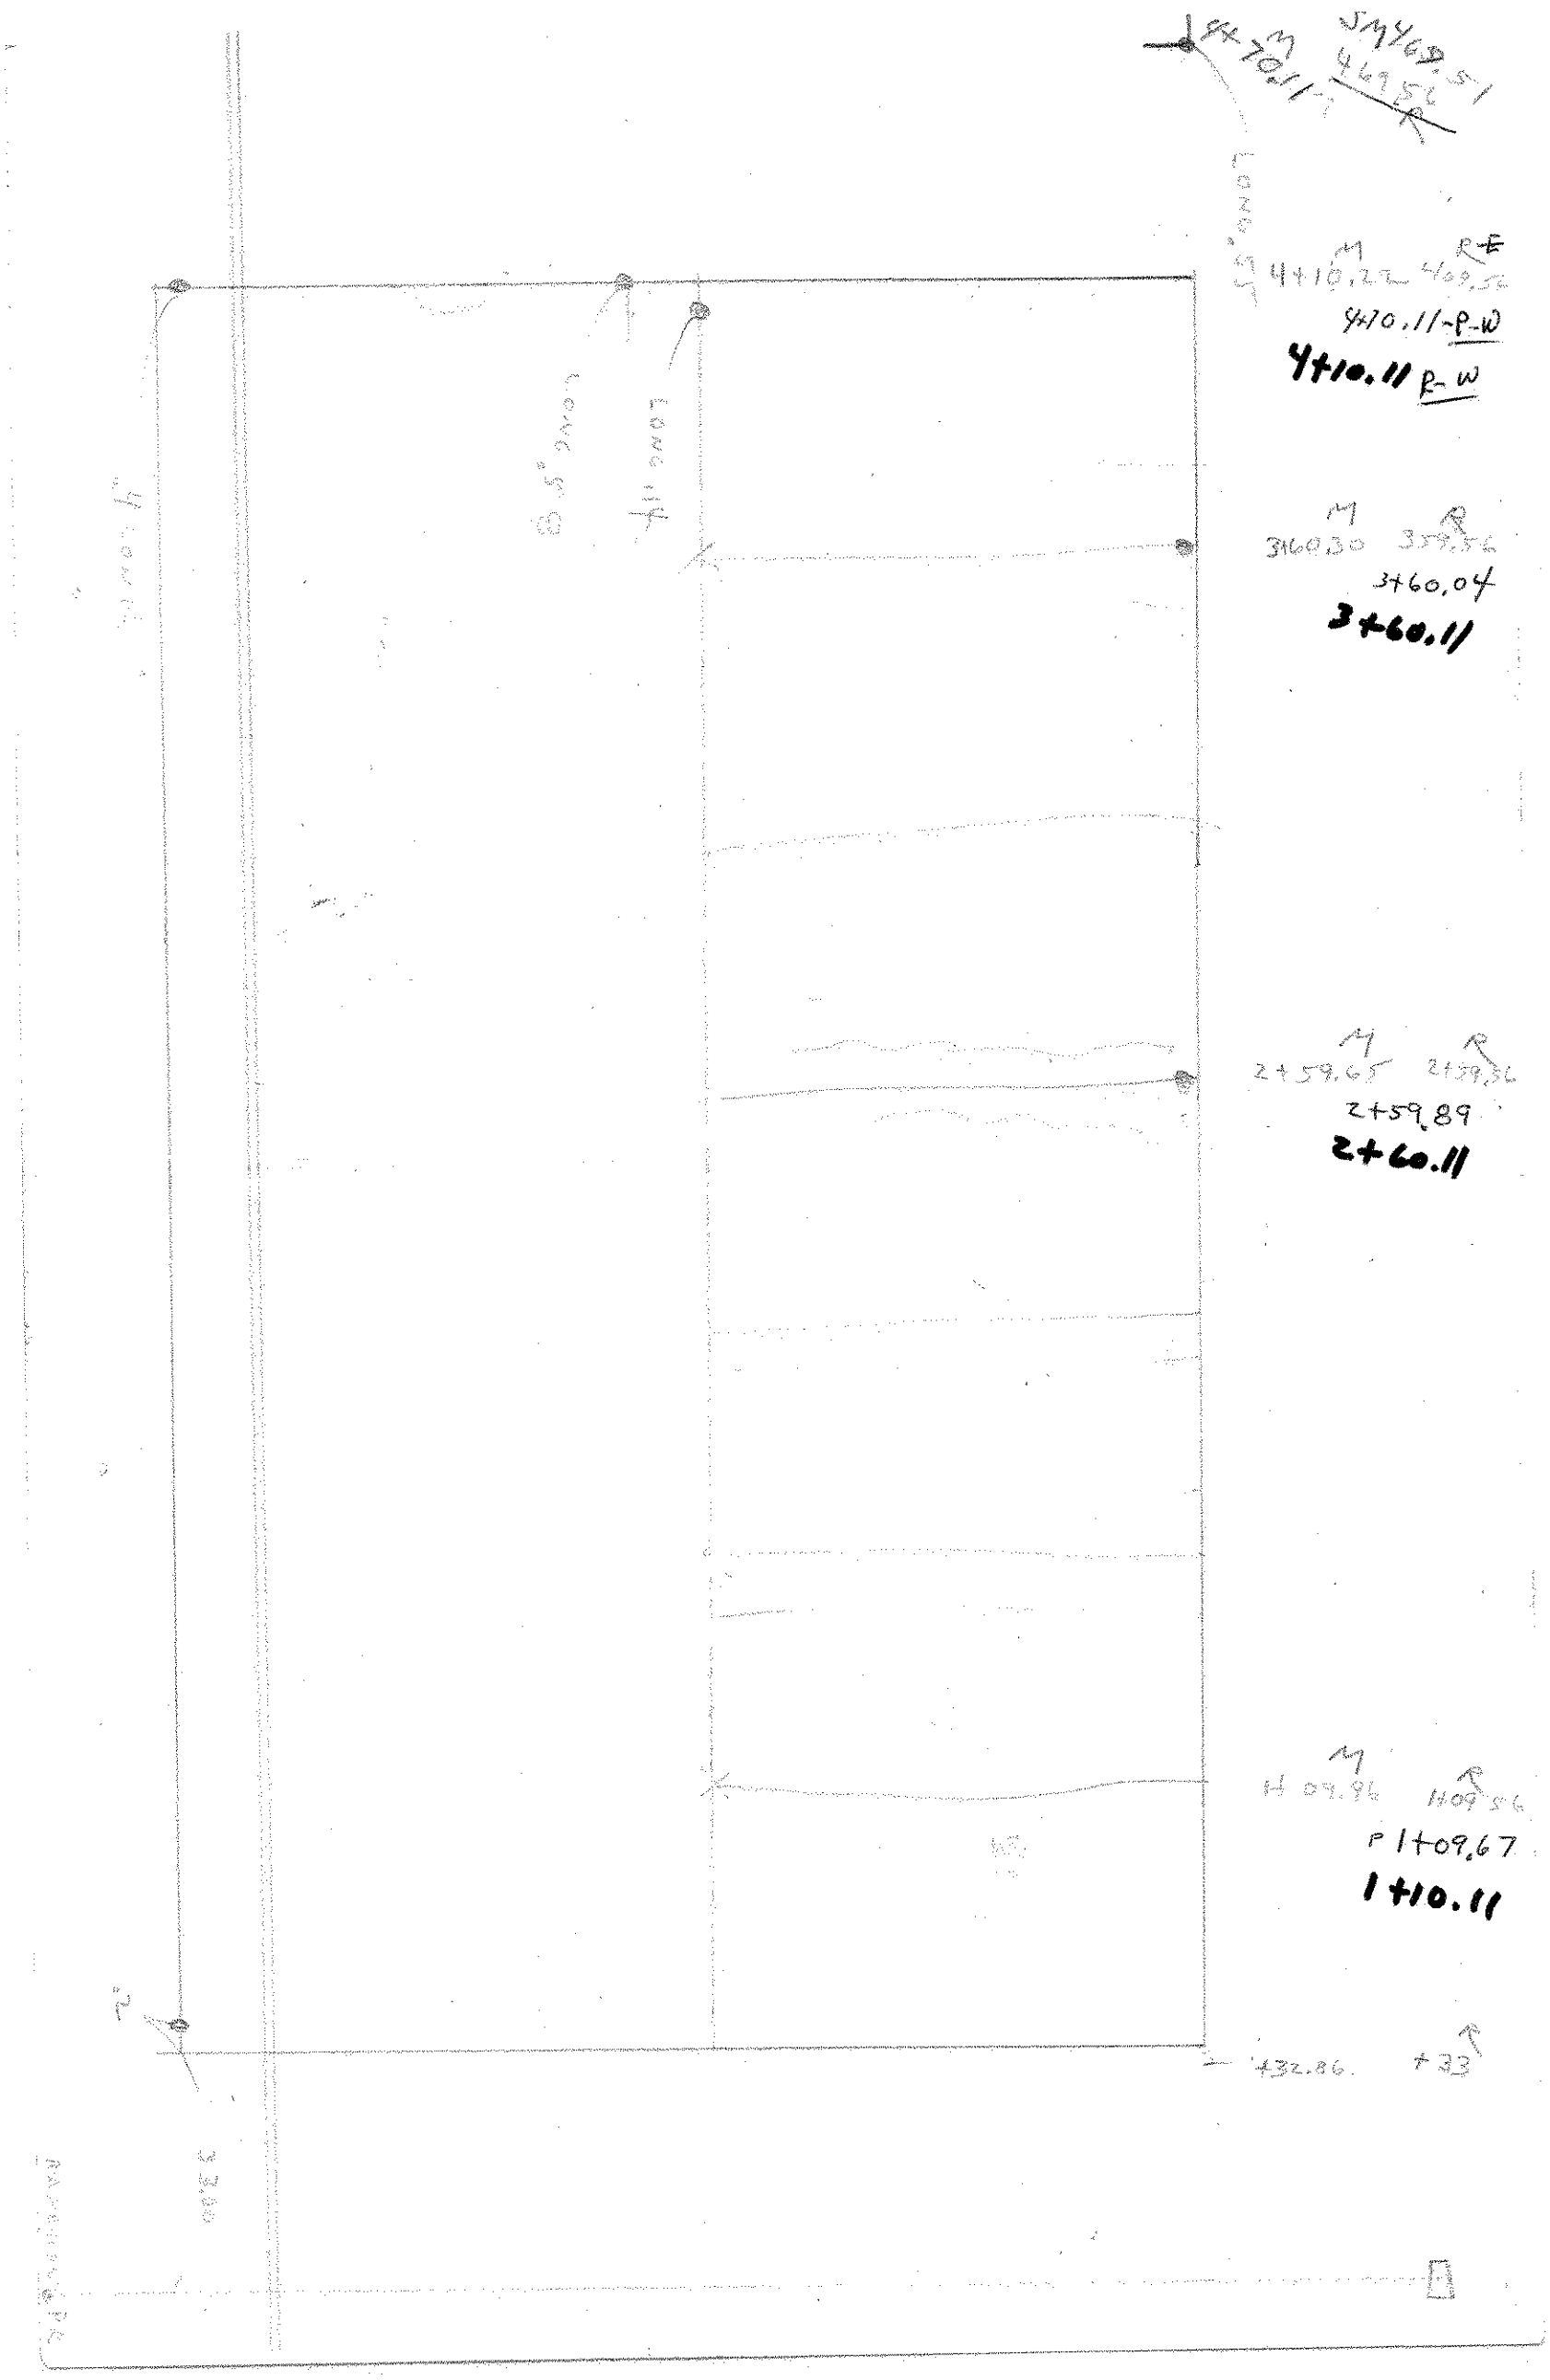
4+10.11 P-W
3+60.11
2+60.11
1+10.11