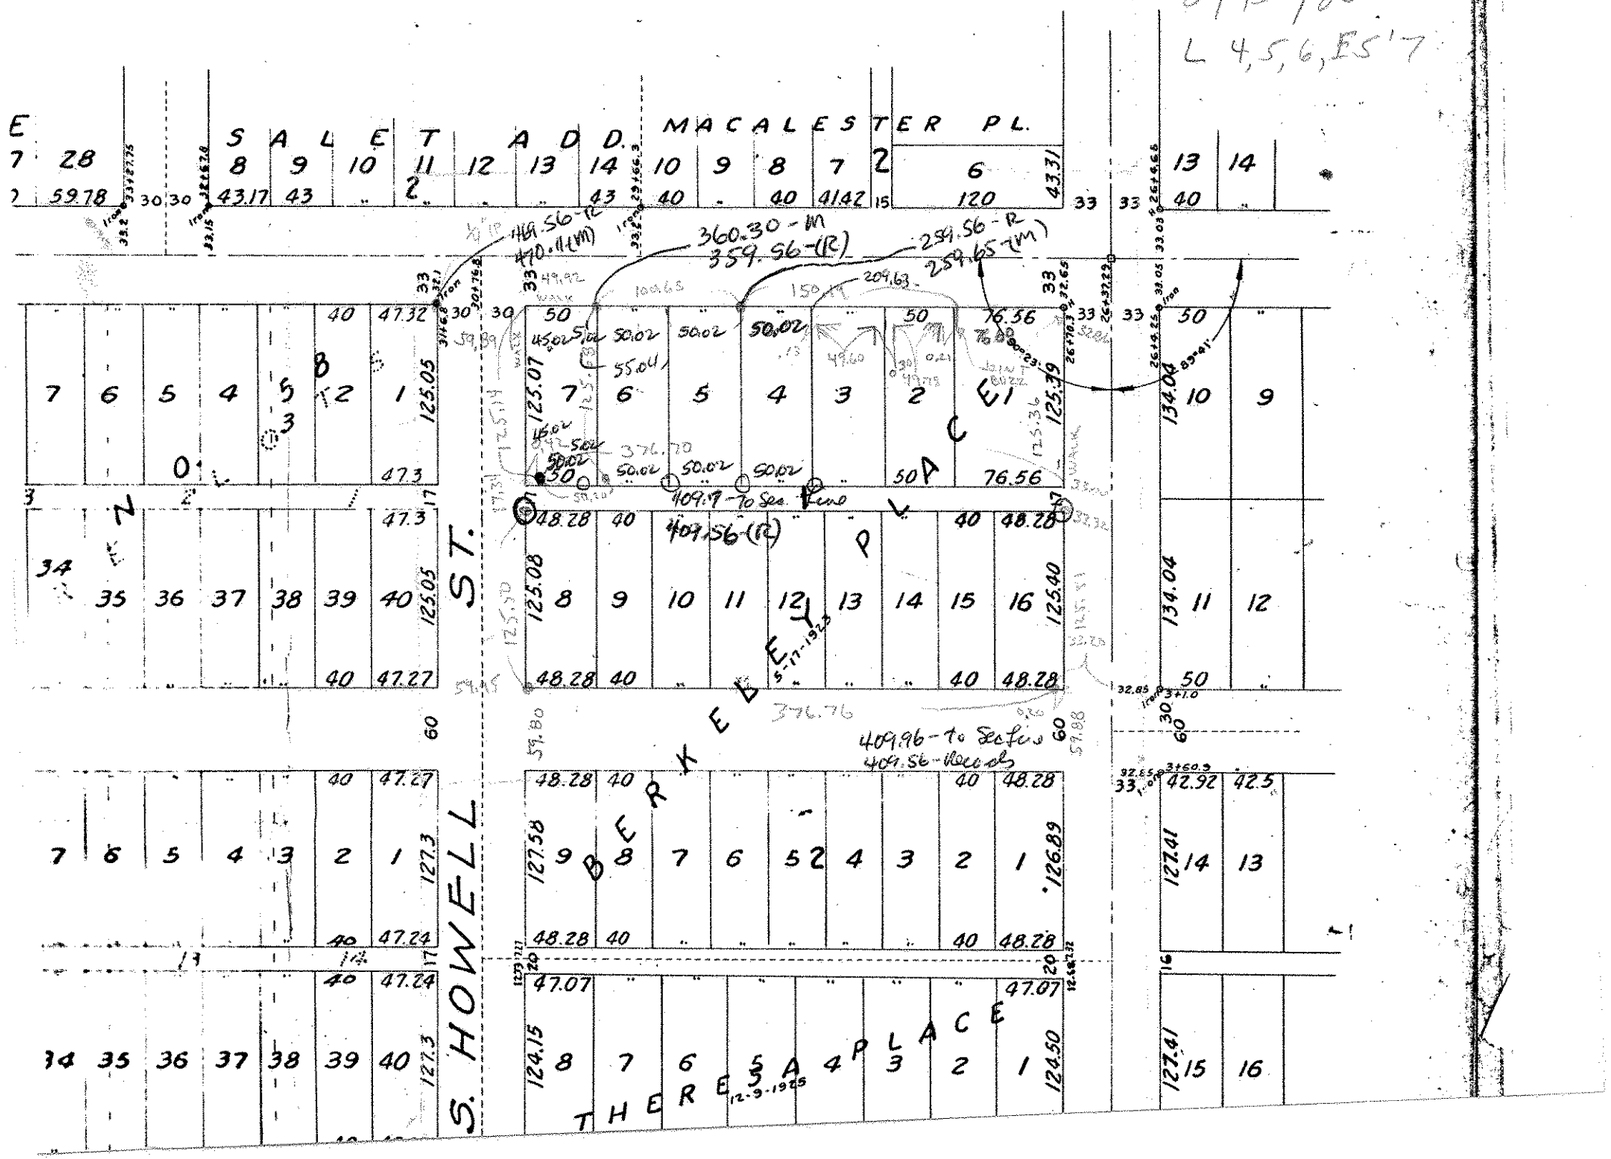AL, KARL & ROBBY
8/15/88
L 4,5,6, E5'7