

TELEPHONE 776-0640


PLAT OF SURVEY

OF PROPERTY OF Louis Leone
DESCRIBED AS FOLLOWS Lots 4 and 5, Block 1, Bernhelmer's Addition
Nº182 Goodrich Ave., St. Paul, Minnesota.

SCALE: 1 INCH = 30 FEET
○ DENOTES IRON

T. J. WELCH, REGISTERED SURVEYOR
701 EAST 3RD STREET, ST. PAUL, MINN. 55106

GOODRICH AVE.

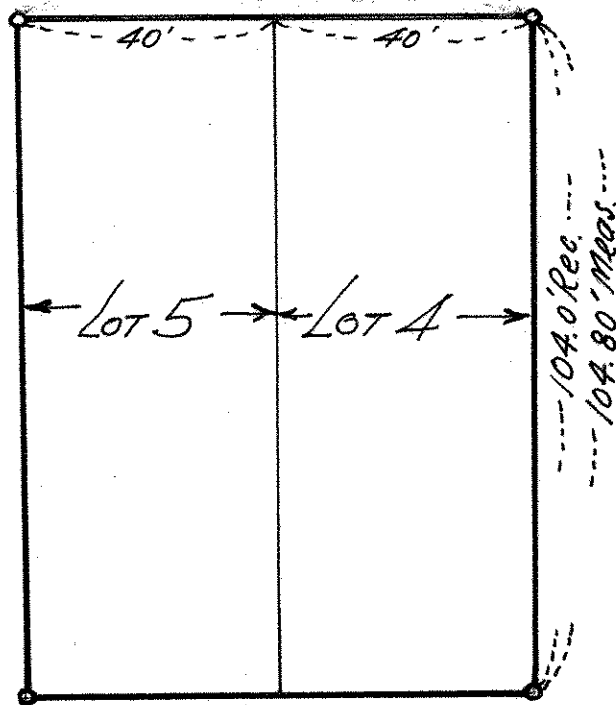

NORTH

20' ALLEY

CERTIFICATE OF SURVEY

I hereby certify that on May 6, 1972
I surveyed the property described above and that the above
plat is a correct representation of said survey.

T. J. Welch

350/15