

TELEPHONE 776-0640

# PLAT OF SURVEY


OF PROPERTY OF Dell Trump  
DESCRIBED AS FOLLOWS Lot 9, Block 3, Bernheimer's Addition, Ramsey  
County  
N<sup>o</sup> 258 Banfil St, St. Paul, Minn.

SCALE: 1 INCH = 30 FEET

O DENOTES IRONS

T. J. WELCH, REGISTERED SURVEYOR  
701 EAST 3RD STREET, ST. PAUL, MINN. 55106

BANFIL ST.

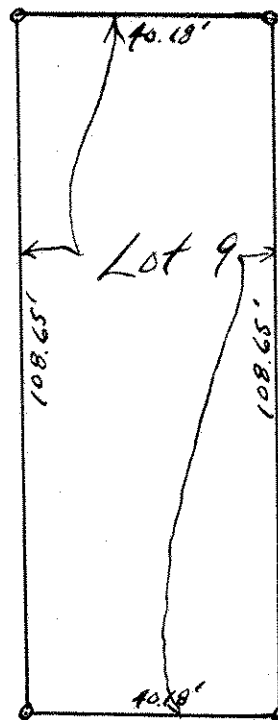

~~This survey is made exclusively for  
First Federal Savings and Loan Assn.  
of St. Paul, Minn. Lot lines are not  
guaranteed as this is survey for  
mortgage purposes only.~~

## CERTIFICATE OF SURVEY

I hereby certify that on June 13, 1974  
I surveyed the property described above and that the above  
plat is a correct representation of said survey.

T. J. Welch

355/  
147