


8-28-23

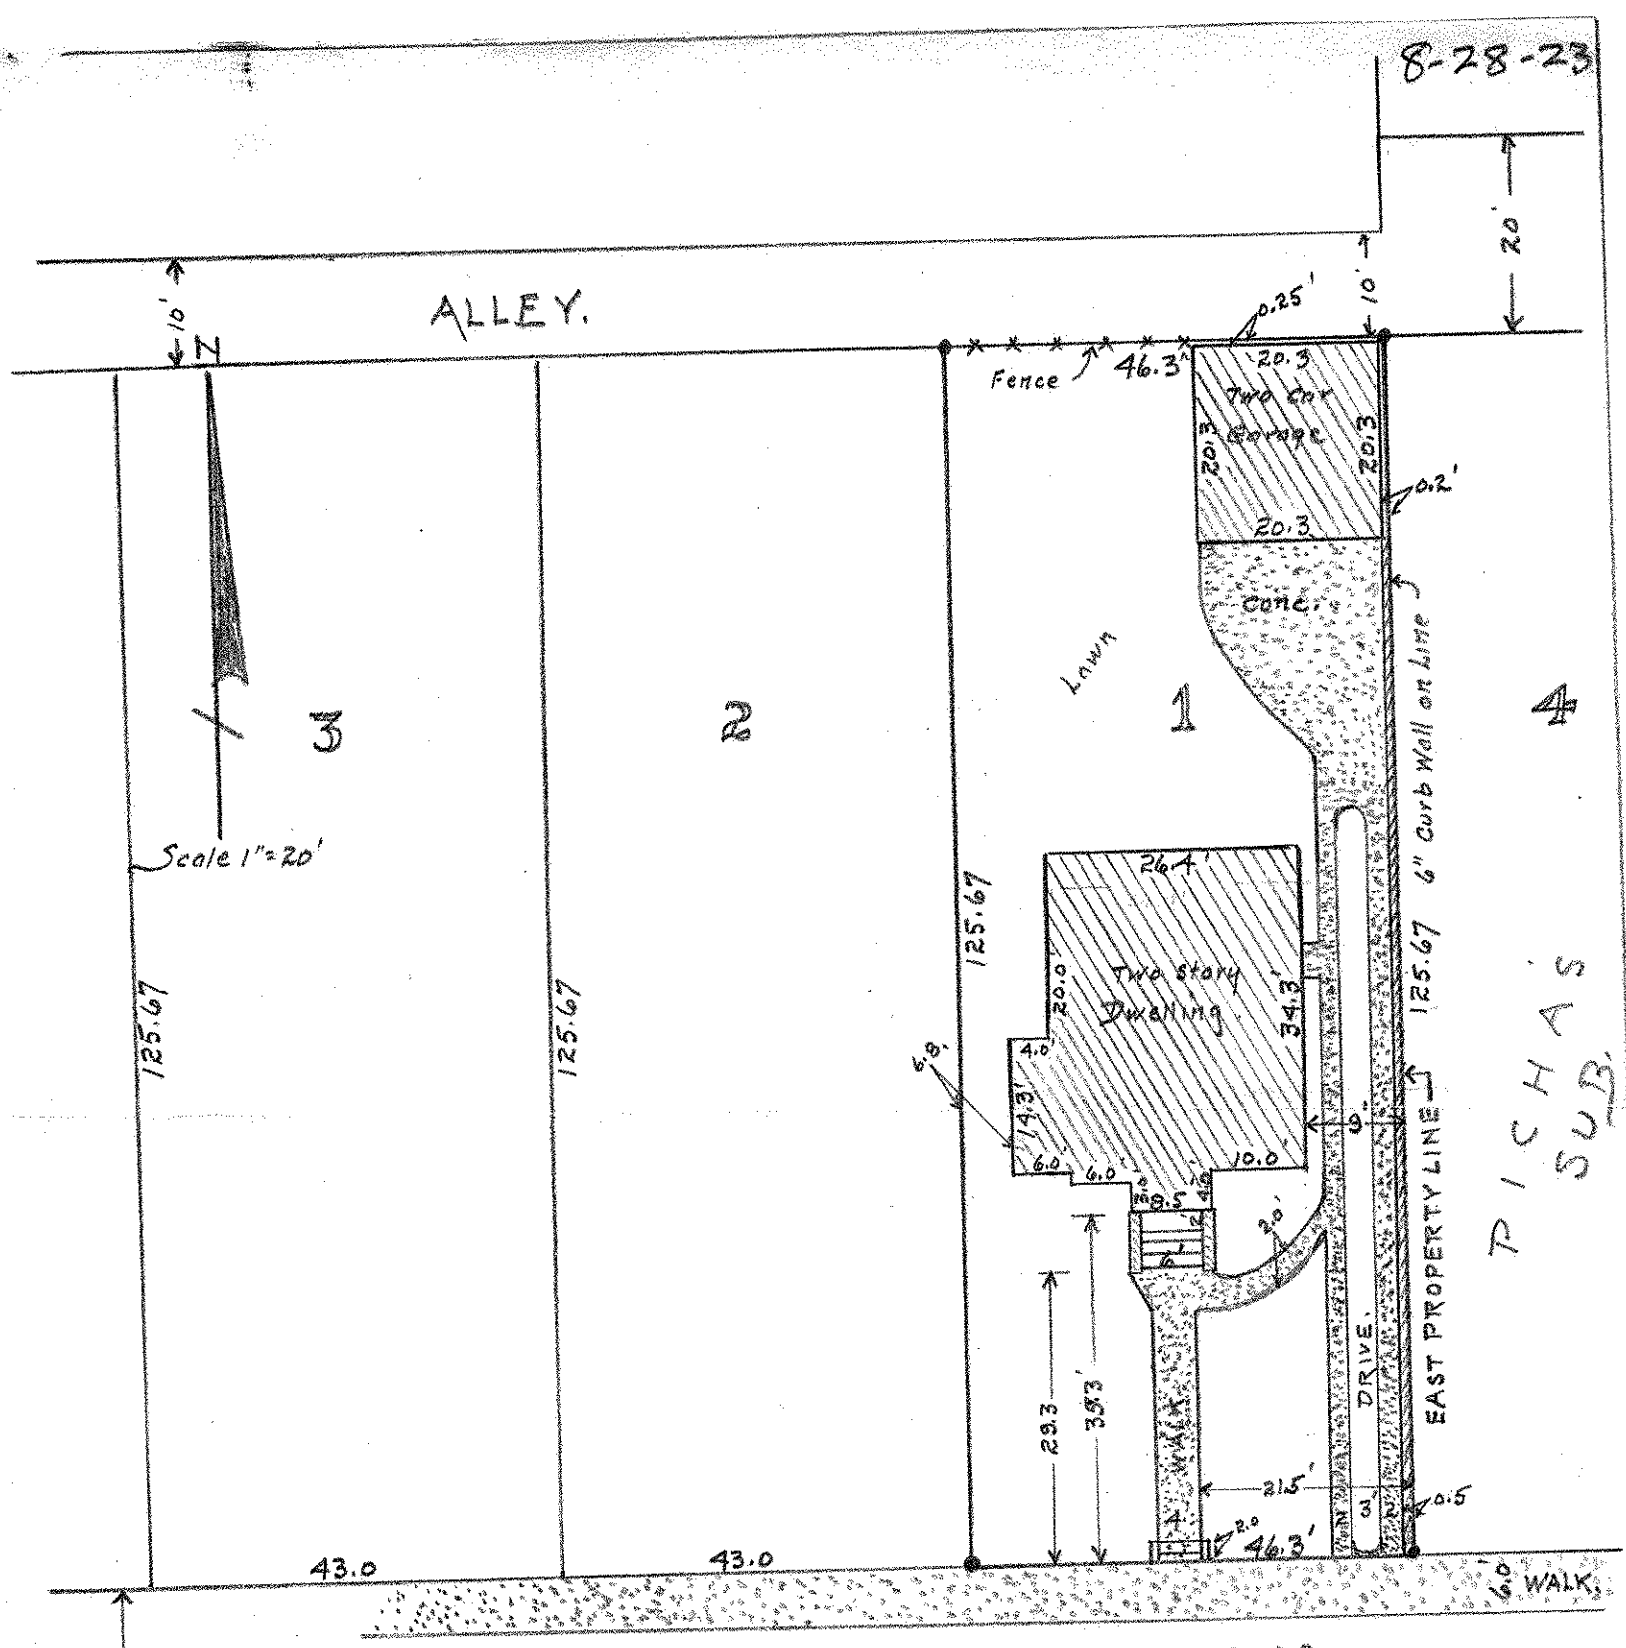

RICHAS
SUB.

House No. 2099

~~HARTFORD~~

This is to certify that the Banister Engineering Co., Registered Professional Engineers, St. Paul Minn. have on this 5th day of October 1936, made a survey of the property described as LOT 1 of BERTHA'S RE-ARRANGEMENT, City of St. Paul Minn. and that all buildings and improvements thereon are shown relative to the property lines and that the annexed plat is true and correct.

Banister Engineering Co. *J. P. Rubin*