


LOTS 3-485 BLOCK 6
BIRMINGHAM'S 4th ADD.

JOHN B. IRVINE, SURVEYOR,
JAN. 15-1909
SCALE 20ft per inch.

MIDDLETON ST.

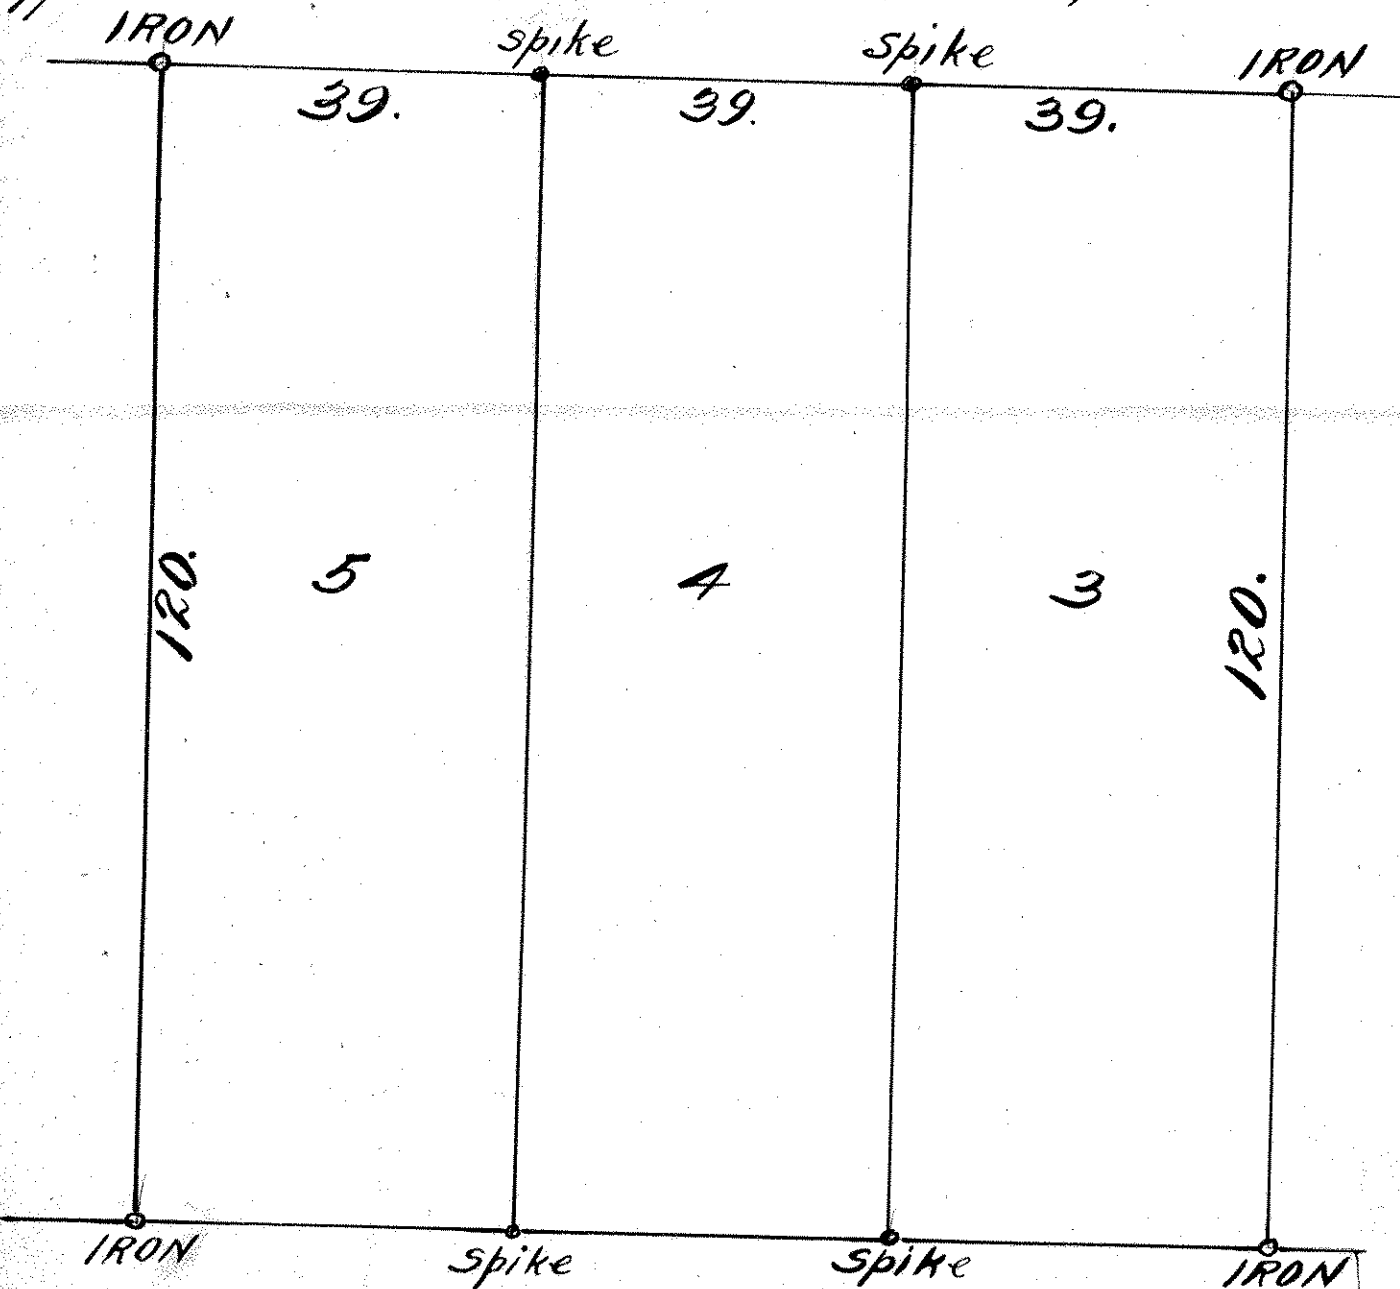

ALLEY, 20