

FROM THE OFFICE OF

CHARLES O. GEORGI COMPANY

2215 West County Road B

Saint Paul, Minnesota 55113

REGISTERED CIVIL ENGINEER AND LAND SURVEYOR



I Hereby Certify that this plat shows a survey made by me of the property described on this plat, and that the corners are correctly placed as shown, and that all locations have been correctly shown.

Project No. Minn A-1-7
Parcel No. 70-B
Area 6,611 sq. ft. m.o.l.

Surveyed For... Housing Authority


Date... March 1976

Scale... 1" = 40'

By *Charles O. Georgi*
REGISTERED LAND SURVEYOR

Description:

The North 10 feet of Lot 2 and the South 40 feet of Lot 3,
Block 4,
Wille's Addition to St. Paul
Ramsey County, Minnesota

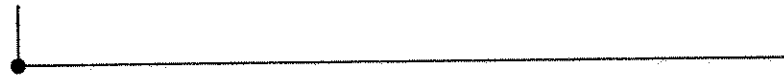

66 MICHIGAN ST. 66



- o Denotes Iron Pipe Monument
- Denotes Iron set by previous survey

