SW 1 28 23

FROM THE OFFICE OF

CHARLES O. GEORGI COMPANY

2215 West County Road B — Saint Paul, Minnesota 55113

REGISTERED CIVIL ENGINEER AND LAND SURVEYOR

Certificate of Survey

I Hereby Certify that this plat shows a survey made by me of the property described on this plat, and that the corners are correctly placed as shown, and that all locations have been correctly shown.

Project No. Minn. A-1-7
Parcel No. 69-A
Area: 7463 Sq.Ft., m.o.l.

Surveyed For Housing Authority
Date July 1976
Scale 1" = 40'

By Charles O. Georgi
REGISTERED LAND SURVEYOR

Description:

Lot 3, Whitane, Turner, and Leppers Subdivision of Block 1, Willes Addition to St. Paul, (abstract)

And the South ½ of Lot 4, Whitane, Turner, and Leppers Subdivision of Block 1, Willes Addition to St. Paul. (registered property)
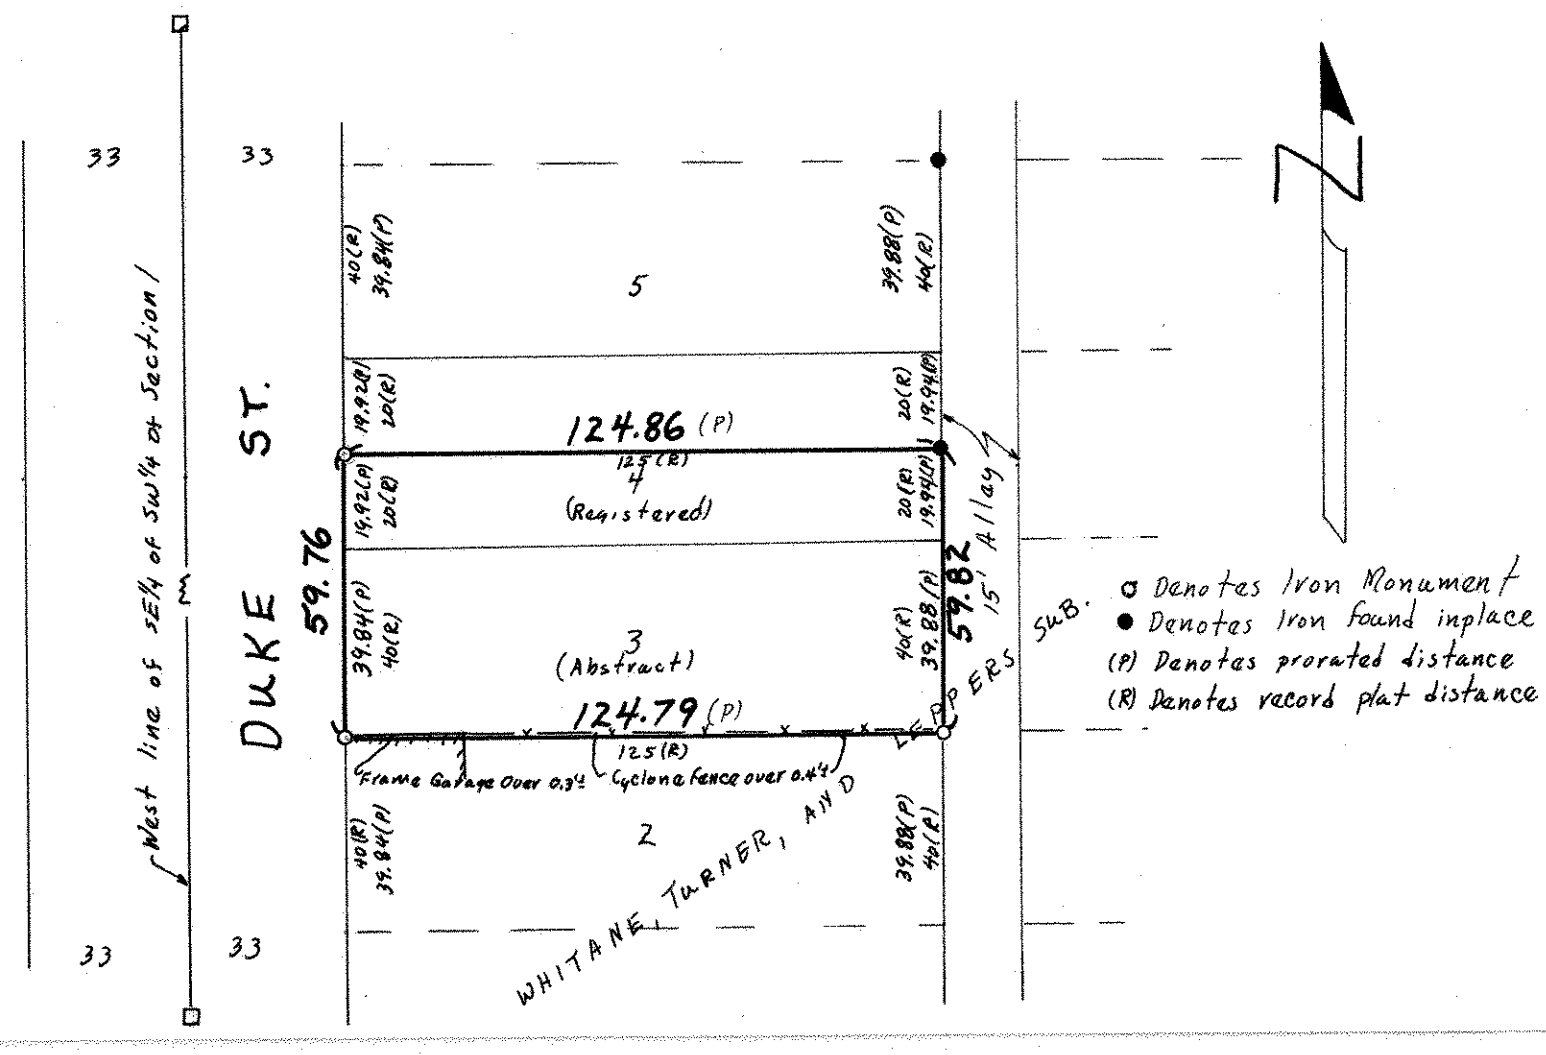
Ramsey County, Minnesota