SW 1-28 23

FROM THE OFFICE OF

CHARLES O. GEORGI COMPANY

2215 West County Road B — Saint Paul, Minnesota 55113

REGISTERED CIVIL ENGINEER AND LAND SURVEYOR

Certificate of Survey

Project No. Minn A-1-7
Parcel No. 66-C
Area 4692 sq. ft. m.o.l.

I Hereby Certify that **this plat shows a survey made by me of the property described on this plat, and that the corners are correctly placed as shown, and that all locations have been correctly shown.**

Surveyed For Housing Authority
Date July 1976
Scale 1" = 40'

By Charles O. Georgi
REGISTERED LAND SURVEYOR

Description:
Lot 1 and the East ½ of Lot 2,
Block 10, Norwood Addition to St. Paul,
Ramsey County, Minnesota.

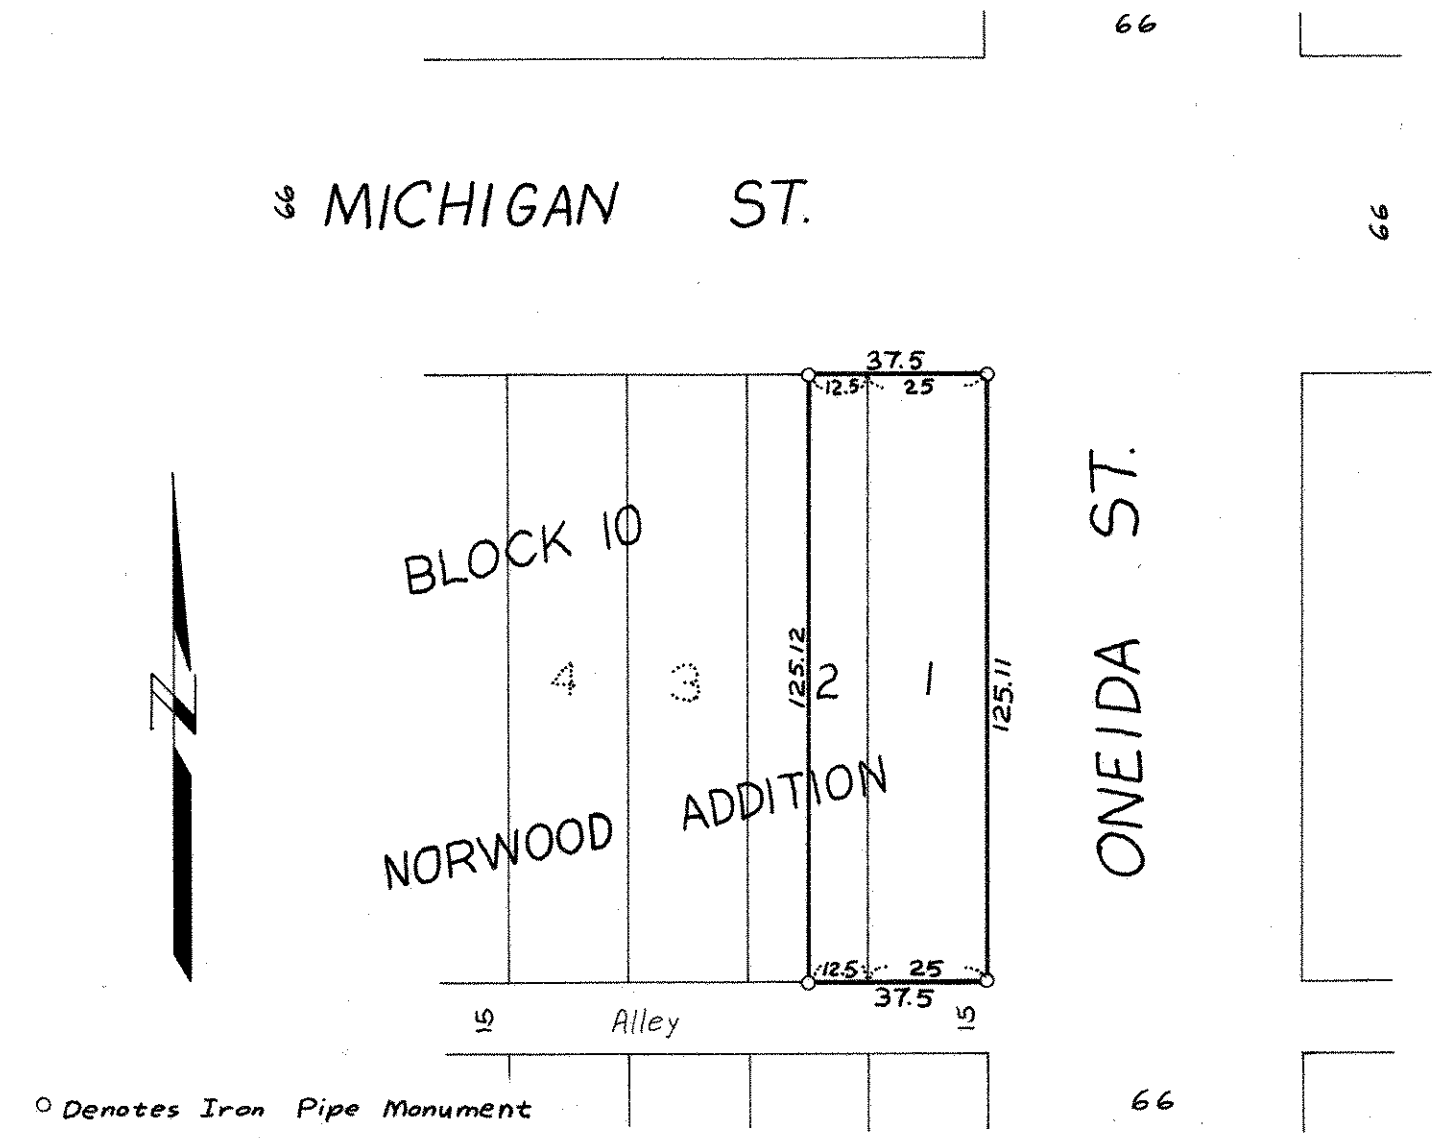

○ Denotes Iron Pipe Monument