SW 1 28 23

FROM THE OFFICE OF

CHARLES O. GEORGI COMPANY

2215 West County Road B — Saint Paul, Minnesota 55113

REGISTERED CIVIL ENGINEER AND LAND SURVEYOR

Certificate of Survey

Project No. Minn A-1-7
Parcel No 70C 70D
Area 2186 sq ft 2186 Sq.ft.m.o.l

I Hereby Certify that **this plat shows a survey made by me of the property described on this plat, and that the corners are correctly placed as shown, and that all locations have been correctly shown.**

Surveyed For Housing Authority

Date Nov. 1976

Scale 1" = 40'

By Charles O. Georgi
REGISTERED LAND SURVEYOR

Description:

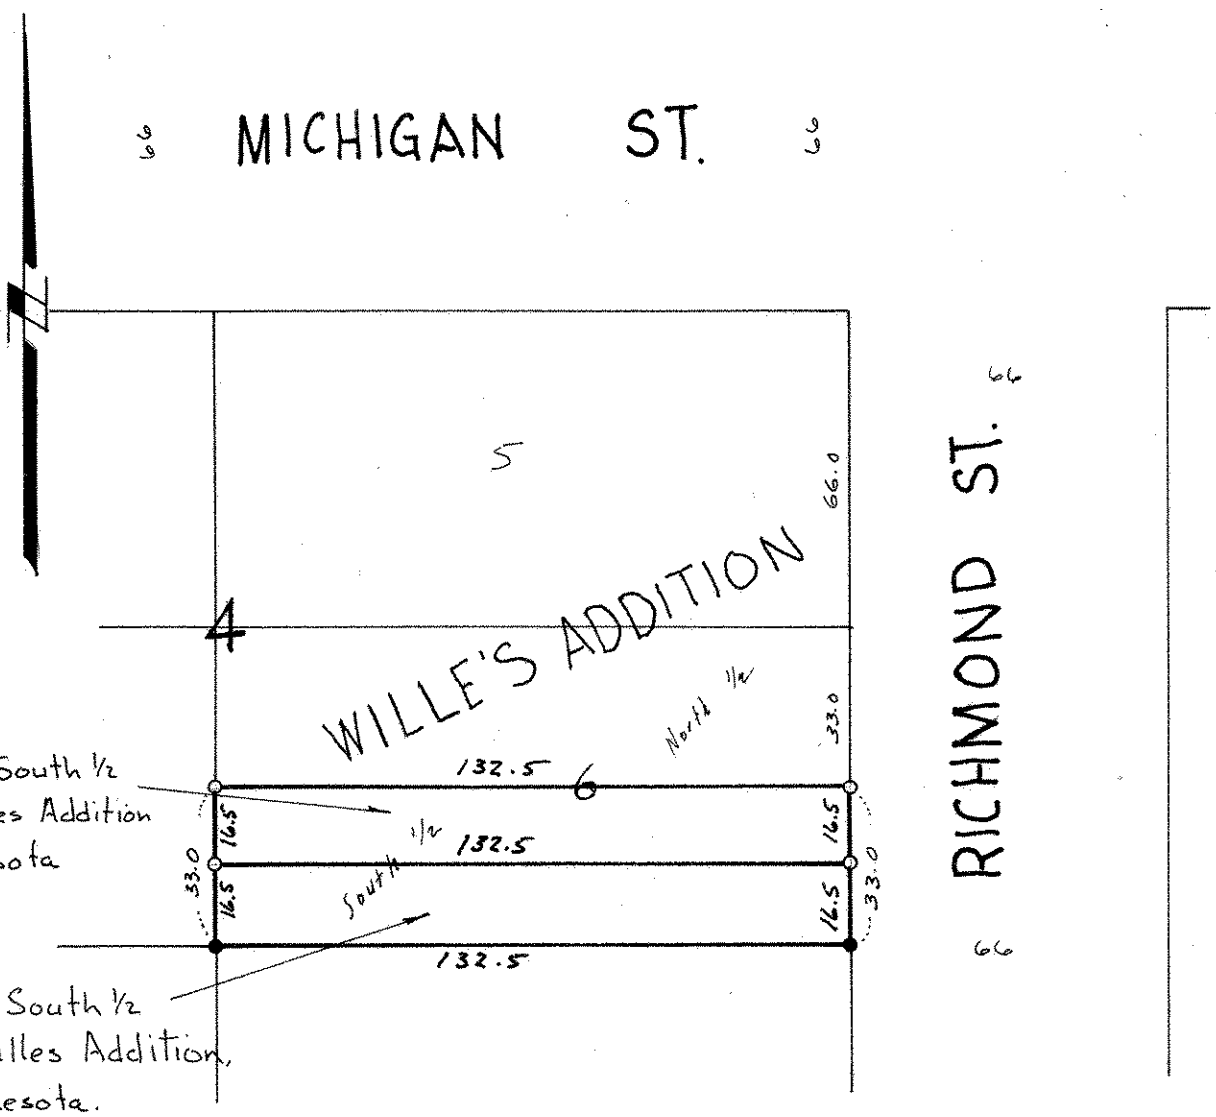

o denotes iron pipe monument

• denotes iron pipe monument found in place

Description 70-C
The North ½ of the South ½ of Lot 6, Block 4, Willes Addition Ramsey County, Minnesota

Description 70-D
The South ½ of the South ½ of lot 6, Block 4, Willes Addition, Ramsey County, Minnesota.