

FROM THE OFFICE OF

CHARLES O. GEORGI COMPANY

2215 West County Road B

Saint Paul, Minnesota 55113

REGISTERED CIVIL ENGINEER AND LAND SURVEYOR

Certificate of Survey

I Hereby Certify that this plat shows a survey made by me of the property described on this plat, and that the corners are correctly placed as shown, and that all locations have been correctly shown.

Surveyed For *Jack P. Madigan*


Date *July 1974*

Scale *1" = 40'*

By *Charles O. Georgi*
REGISTERED LAND SURVEYOR

Description:

*Lot 10,
Block 8,
Elmer and Morrison's Rearrangement
of part of Macalester Park,
Ramsey County,
Minnesota.*

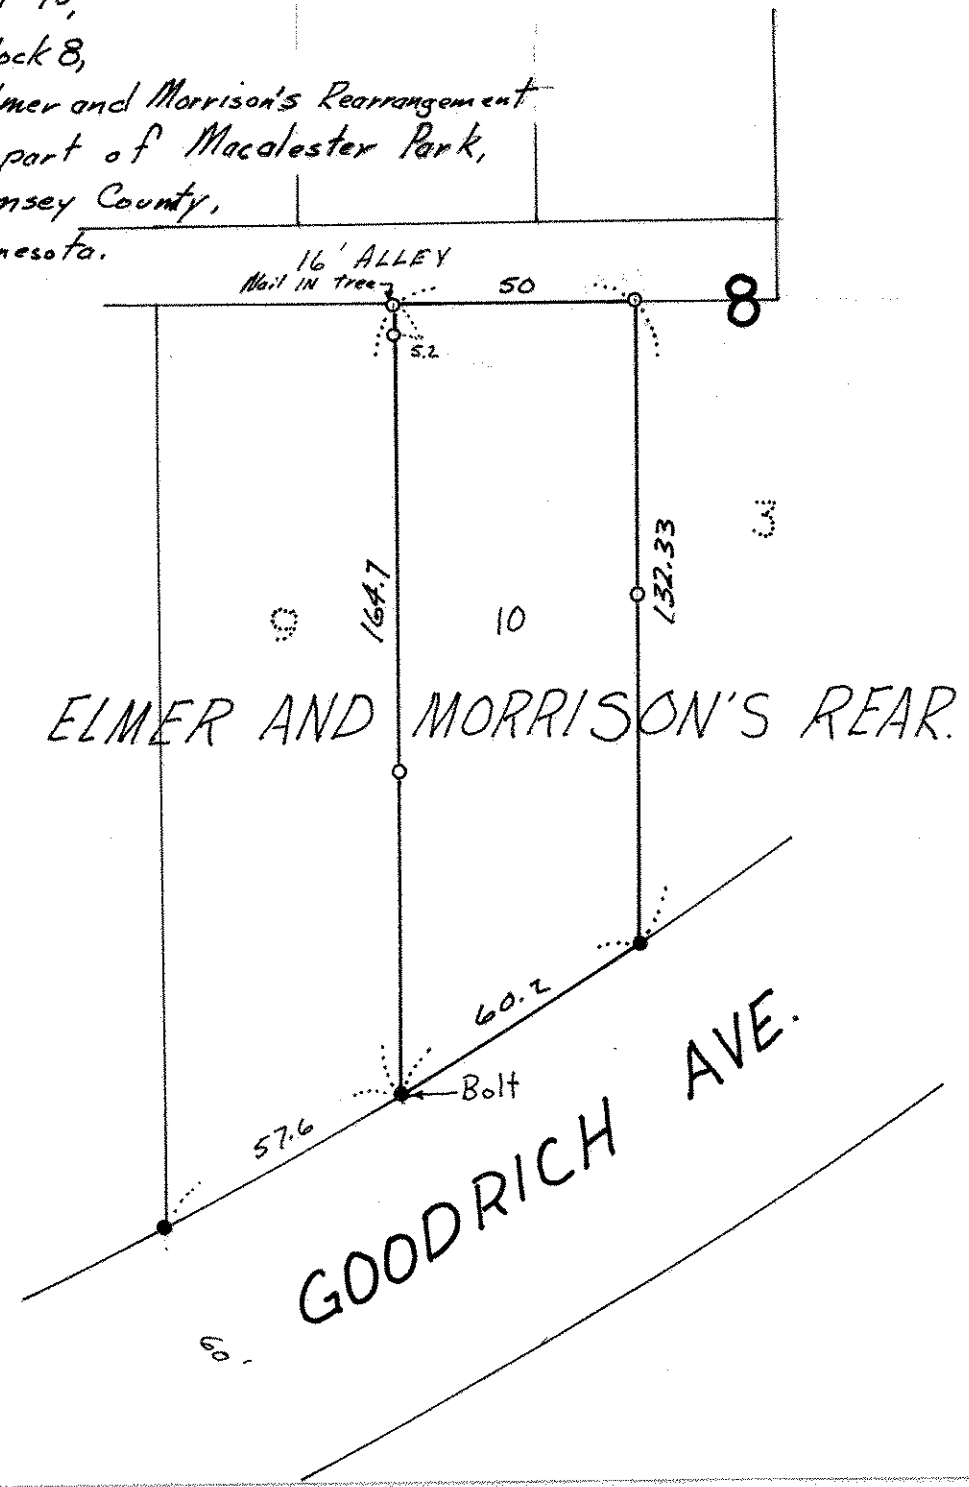

*o denotes iron pipe
MONUMENTS*

*● denotes iron MONUMENT
found in place*