SE 4-28-23

FROM THE OFFICE OF

CHARLES O. GEORGI COMPANY

2215 West County Road B Saint Paul, Minnesota 55113

REGISTERED CIVIL ENGINEER AND LAND SURVEYOR

Certificate of Survey

I Hereby Certify that this plat shows a survey made by me of the property described on this plat, and that the corners are correctly placed as shown, and that all locations have been correctly shown.

Surveyed For Macalester College

Date March 1970

Scale 1" = 30'

By Charles O. Georgi
REGISTERED LAND SURVEYOR
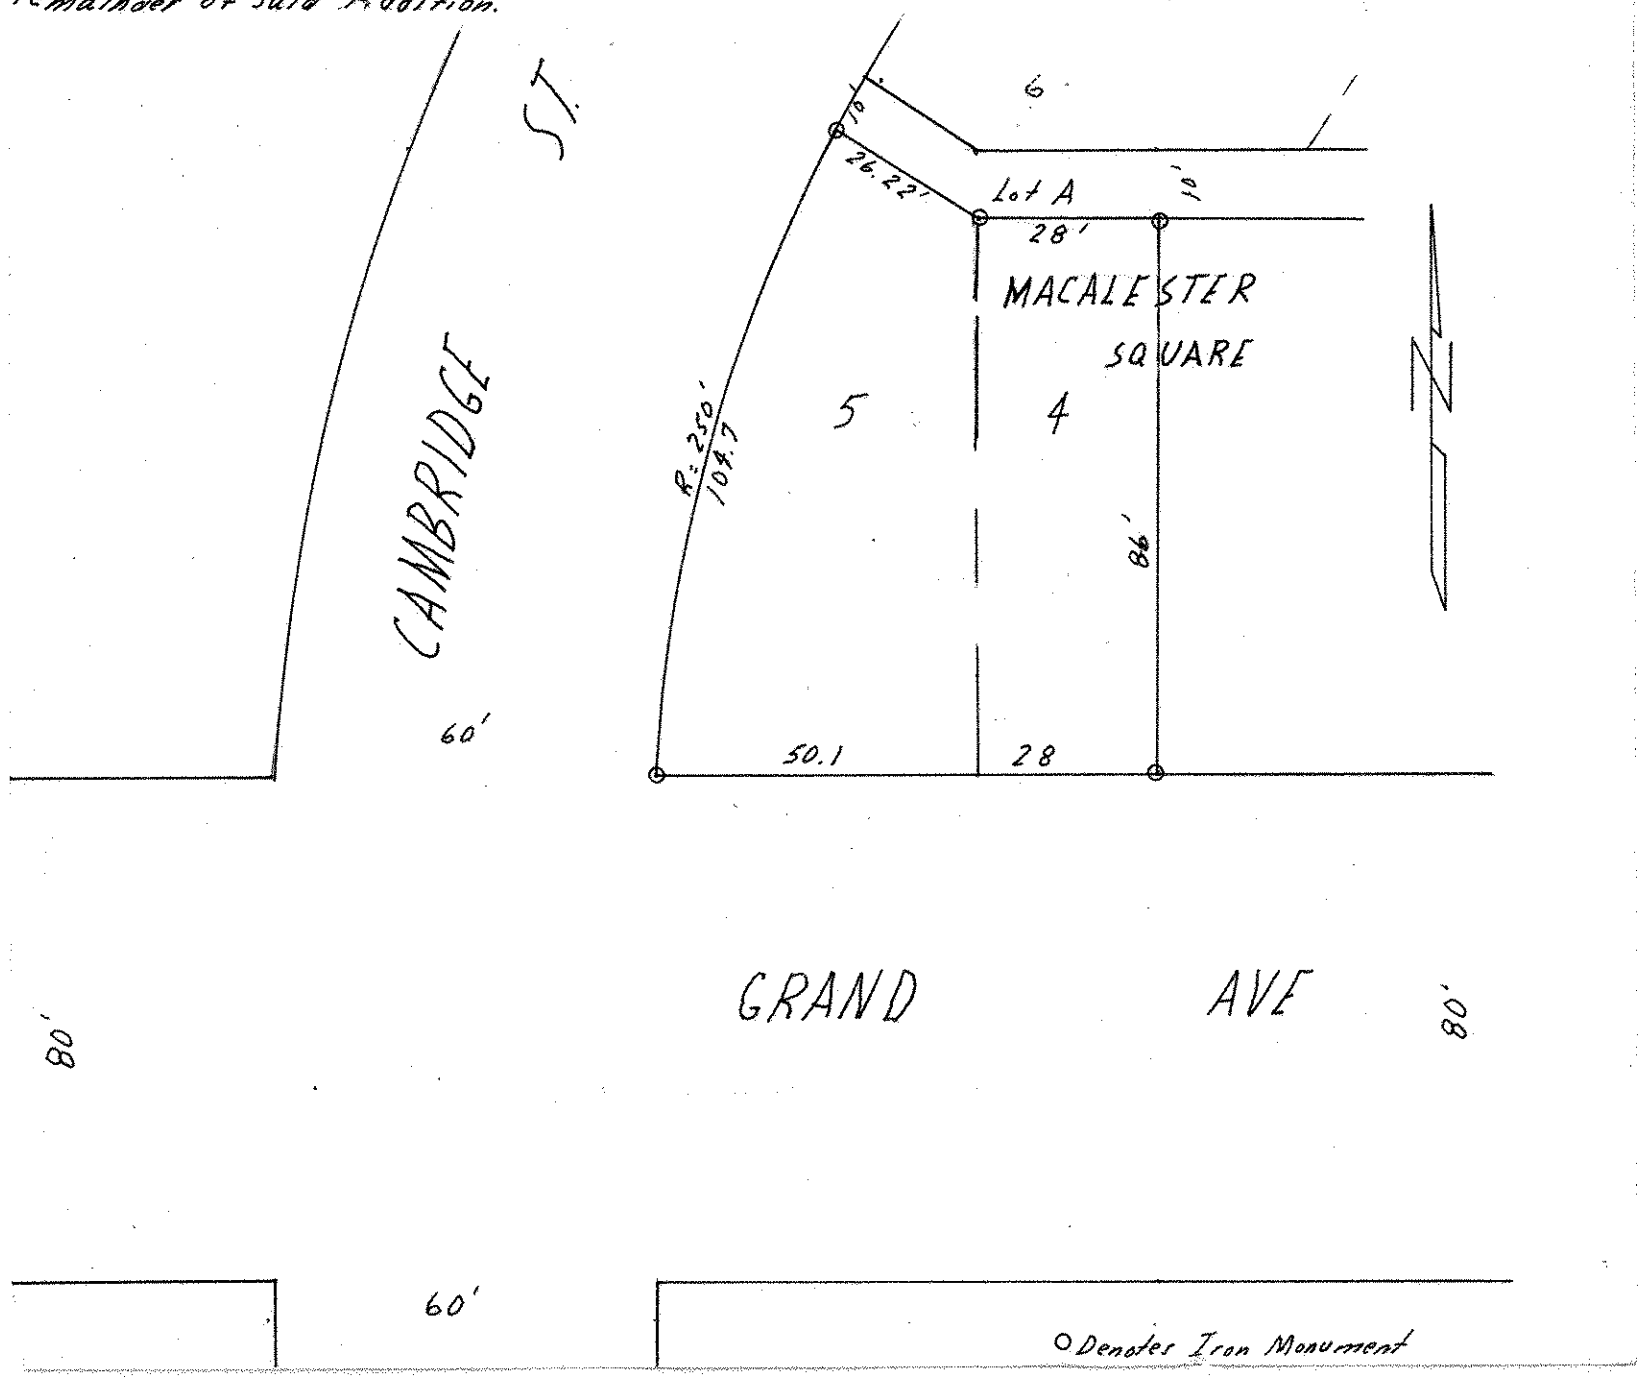
Description: Lots 4 and 5 in Macalester Square, according to the plat thereof recorded in Book 27 of Town Plats, page 12, said premises being located at the Northeast corner of Grand Avenue and Cambridge Avenue in the City of St. Paul, together with a right of way over Lot A in said Addition to be used as a private alley and driveway in common with the owners of the remainder of said Addition.