


LOT 25  
BARTON'S ADD.

JOHN B. IRVINE, SURVEYOR.  
408 GLOBE BLDG.  
ST. PAUL, MINN.  
MAY 10-1917.  
Scale 20ft. per inch.

ALLEY, 20

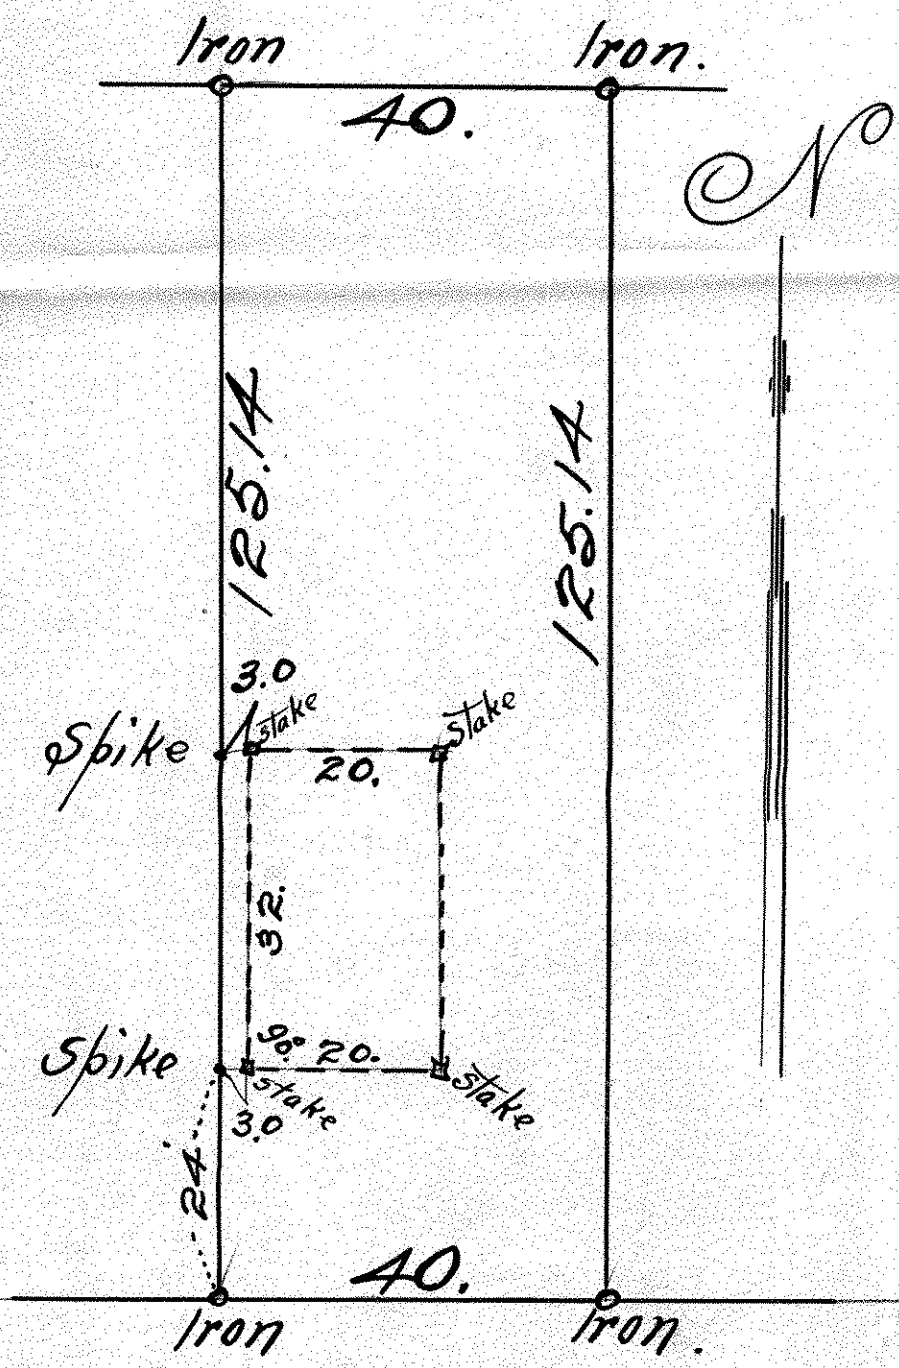

BAYARD ST.