


LOT 14 BLOCK 2  
- BROWN'S 1<sup>ST</sup> ADD.  
20' = 1" • = stake  
JUNE 14<sup>TH</sup> 04 Jas. F. Clifford

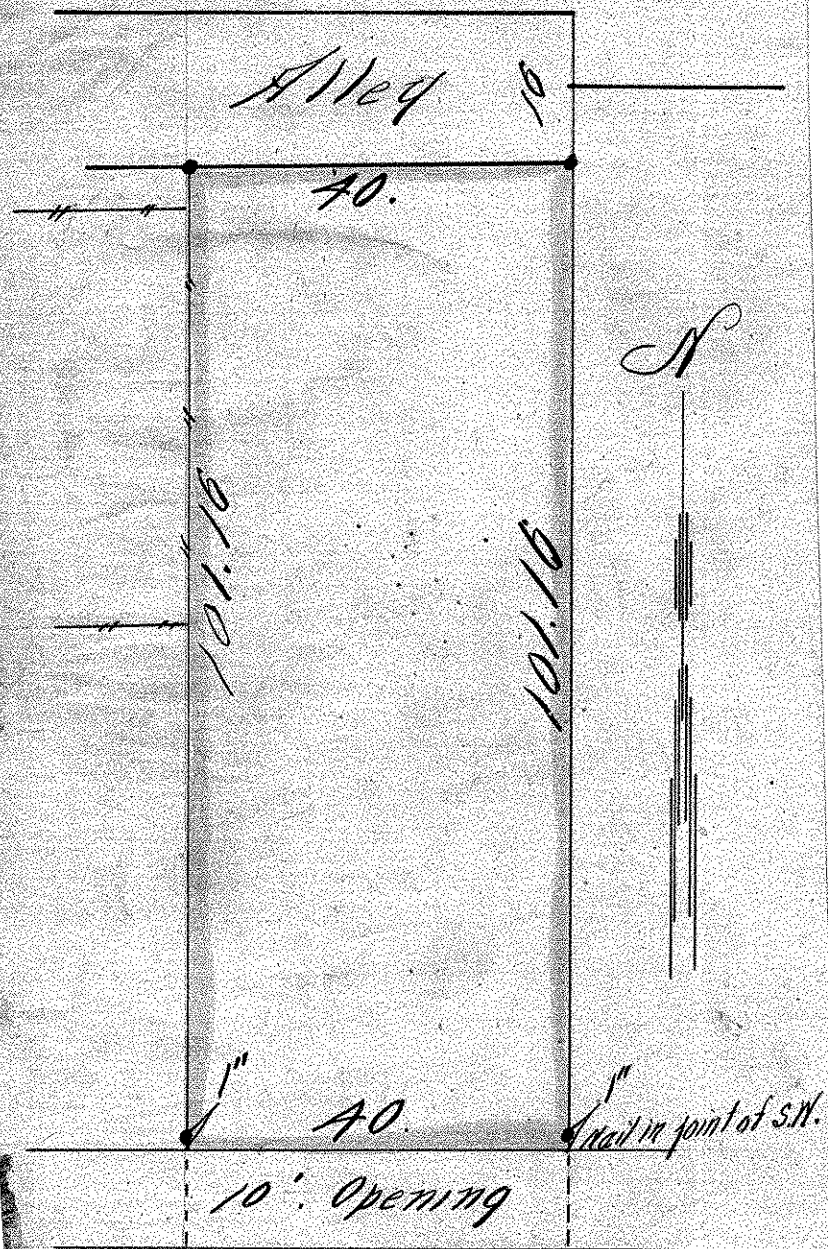

SELBY AVE.