


LOT 8, EXCEPT WEST 50 ft. &
ALL LOT 9. BLOCK 2.

BROWN'S 1ST ADD.


John B. Irvine, Surveyor.

July 21-1921.

Scale. 20 ft. per inch.

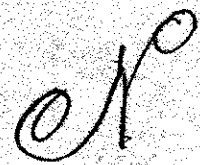

MILTON ST.

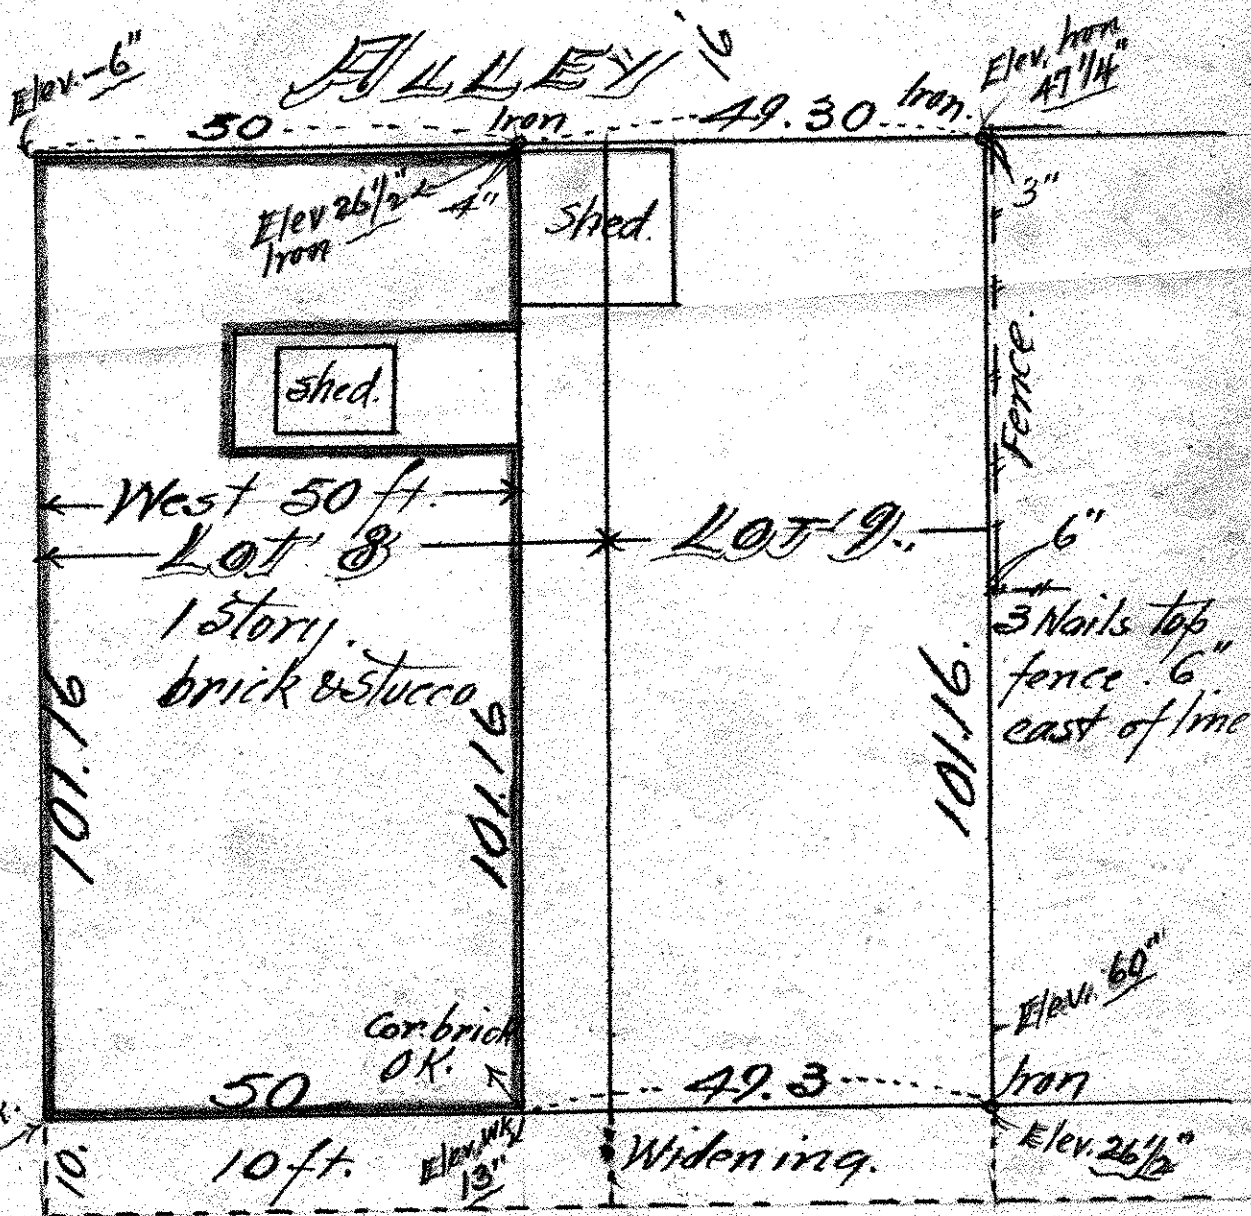

SELBY AVE.