


LOTS 2 & 3 BLOCK 4
BROWN'S FIRST ADD.
scale 20 feet pr inch
SUR. Sep. 9th 1902

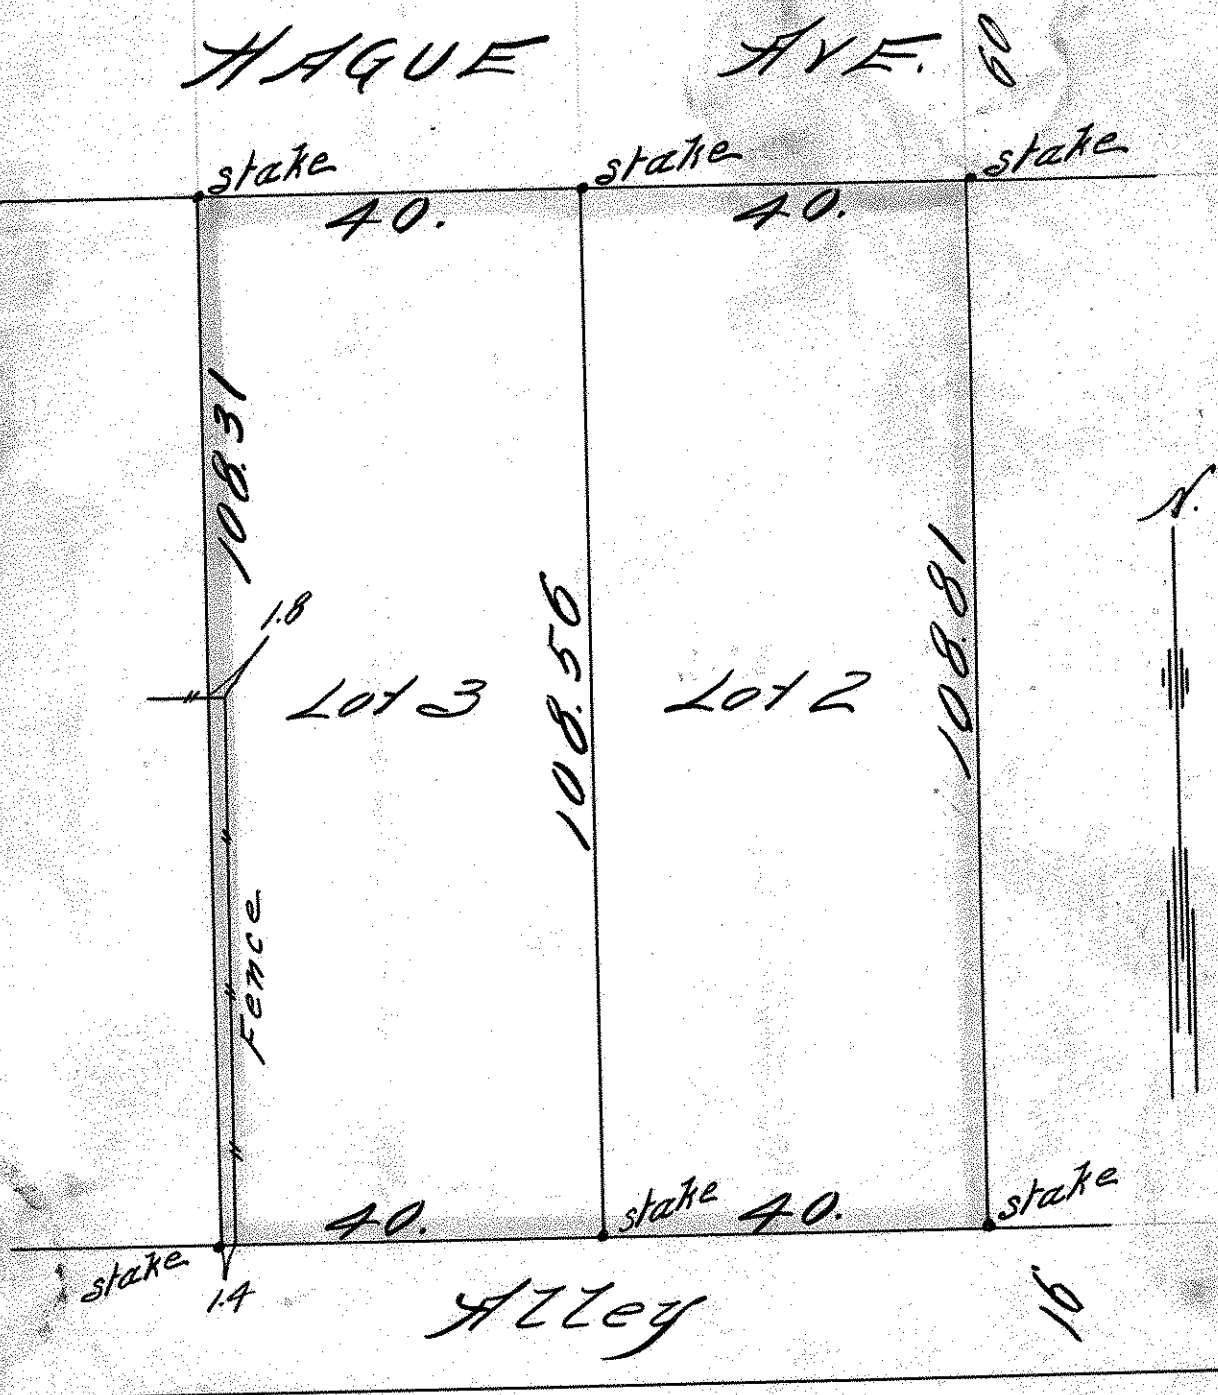

B.47.P.78.