## Certificate of Survey

From the office of

## GEORGI- SCHMIDT & ASSOC. INC.

3092 No. Lexington Ave., Roseville, Mn. 55113 LAND SURVEYING 483-4408

I Hereby Certify that this plat shows a survey made by me of the property described on this plat, and that the corners are correctly placed as shown, and that all locations have been correctly shown.


Surveyed	For James	Stopelotead-Attorney
Date	7/1/80	
Scale	1"=40"	By Canald W. Schmidt
		REGISTERED LAND SURVEYOR

Description:

Job Number: \_\_

Lot 12 and the North 31 feet of the West 10 feet of Lot II, Block 9, Woodland Park.

Ramsey County, Minnesota

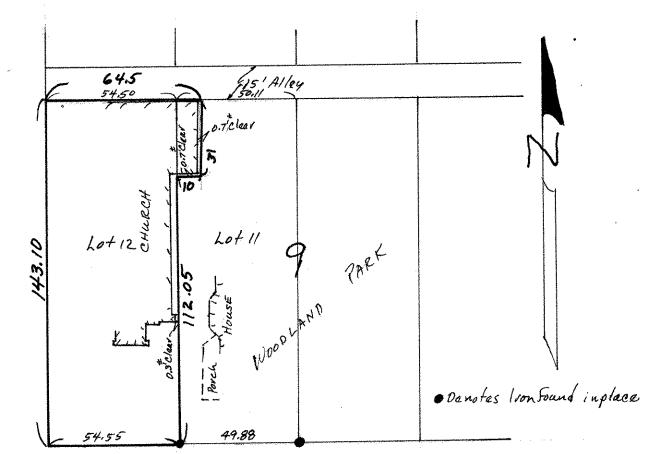

ASHLAND AUE.

0