NE 8-28-23

Certificate of Survey

From the office of

GEORGI- SCHMIDT & ASSOC. INC.

3092 No. Lexington Ave., Roseville, Mn. 55113

LAND SURVEYING

483-4408

I Hereby Certify that this plat shows a survey made by me of the property described on this plat, and that the corners are correctly placed as shown,

Job Number: 1578

Surveyed For Theodore Skare

Date 4/28/84

Scale 1"=50'

By _____ REGISTERED LAND SURVEYOR #10459

Description:
Lots 34 and 35, Block 1, Mississippi View, being Auditor's Subdivision No. 59.

Ramsey County, Minnesota

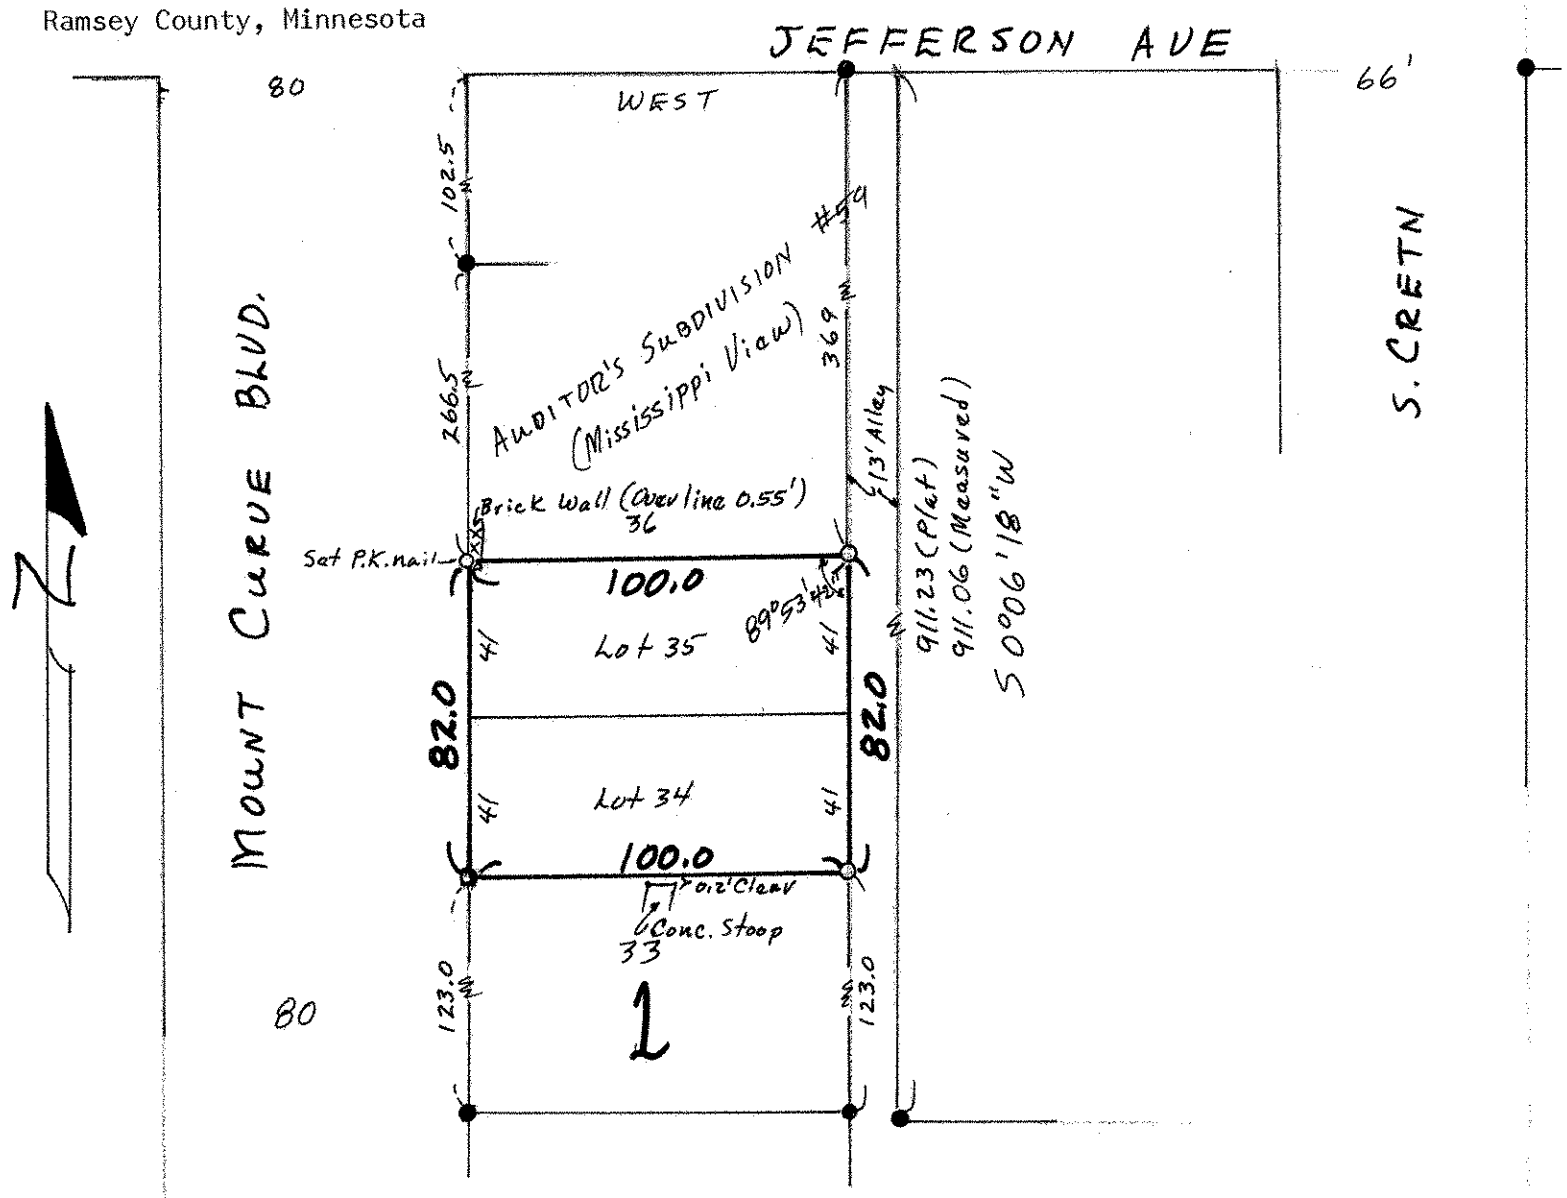

● Denotes Iron Found in place

○ Denotes Iron Pipe Monument Set