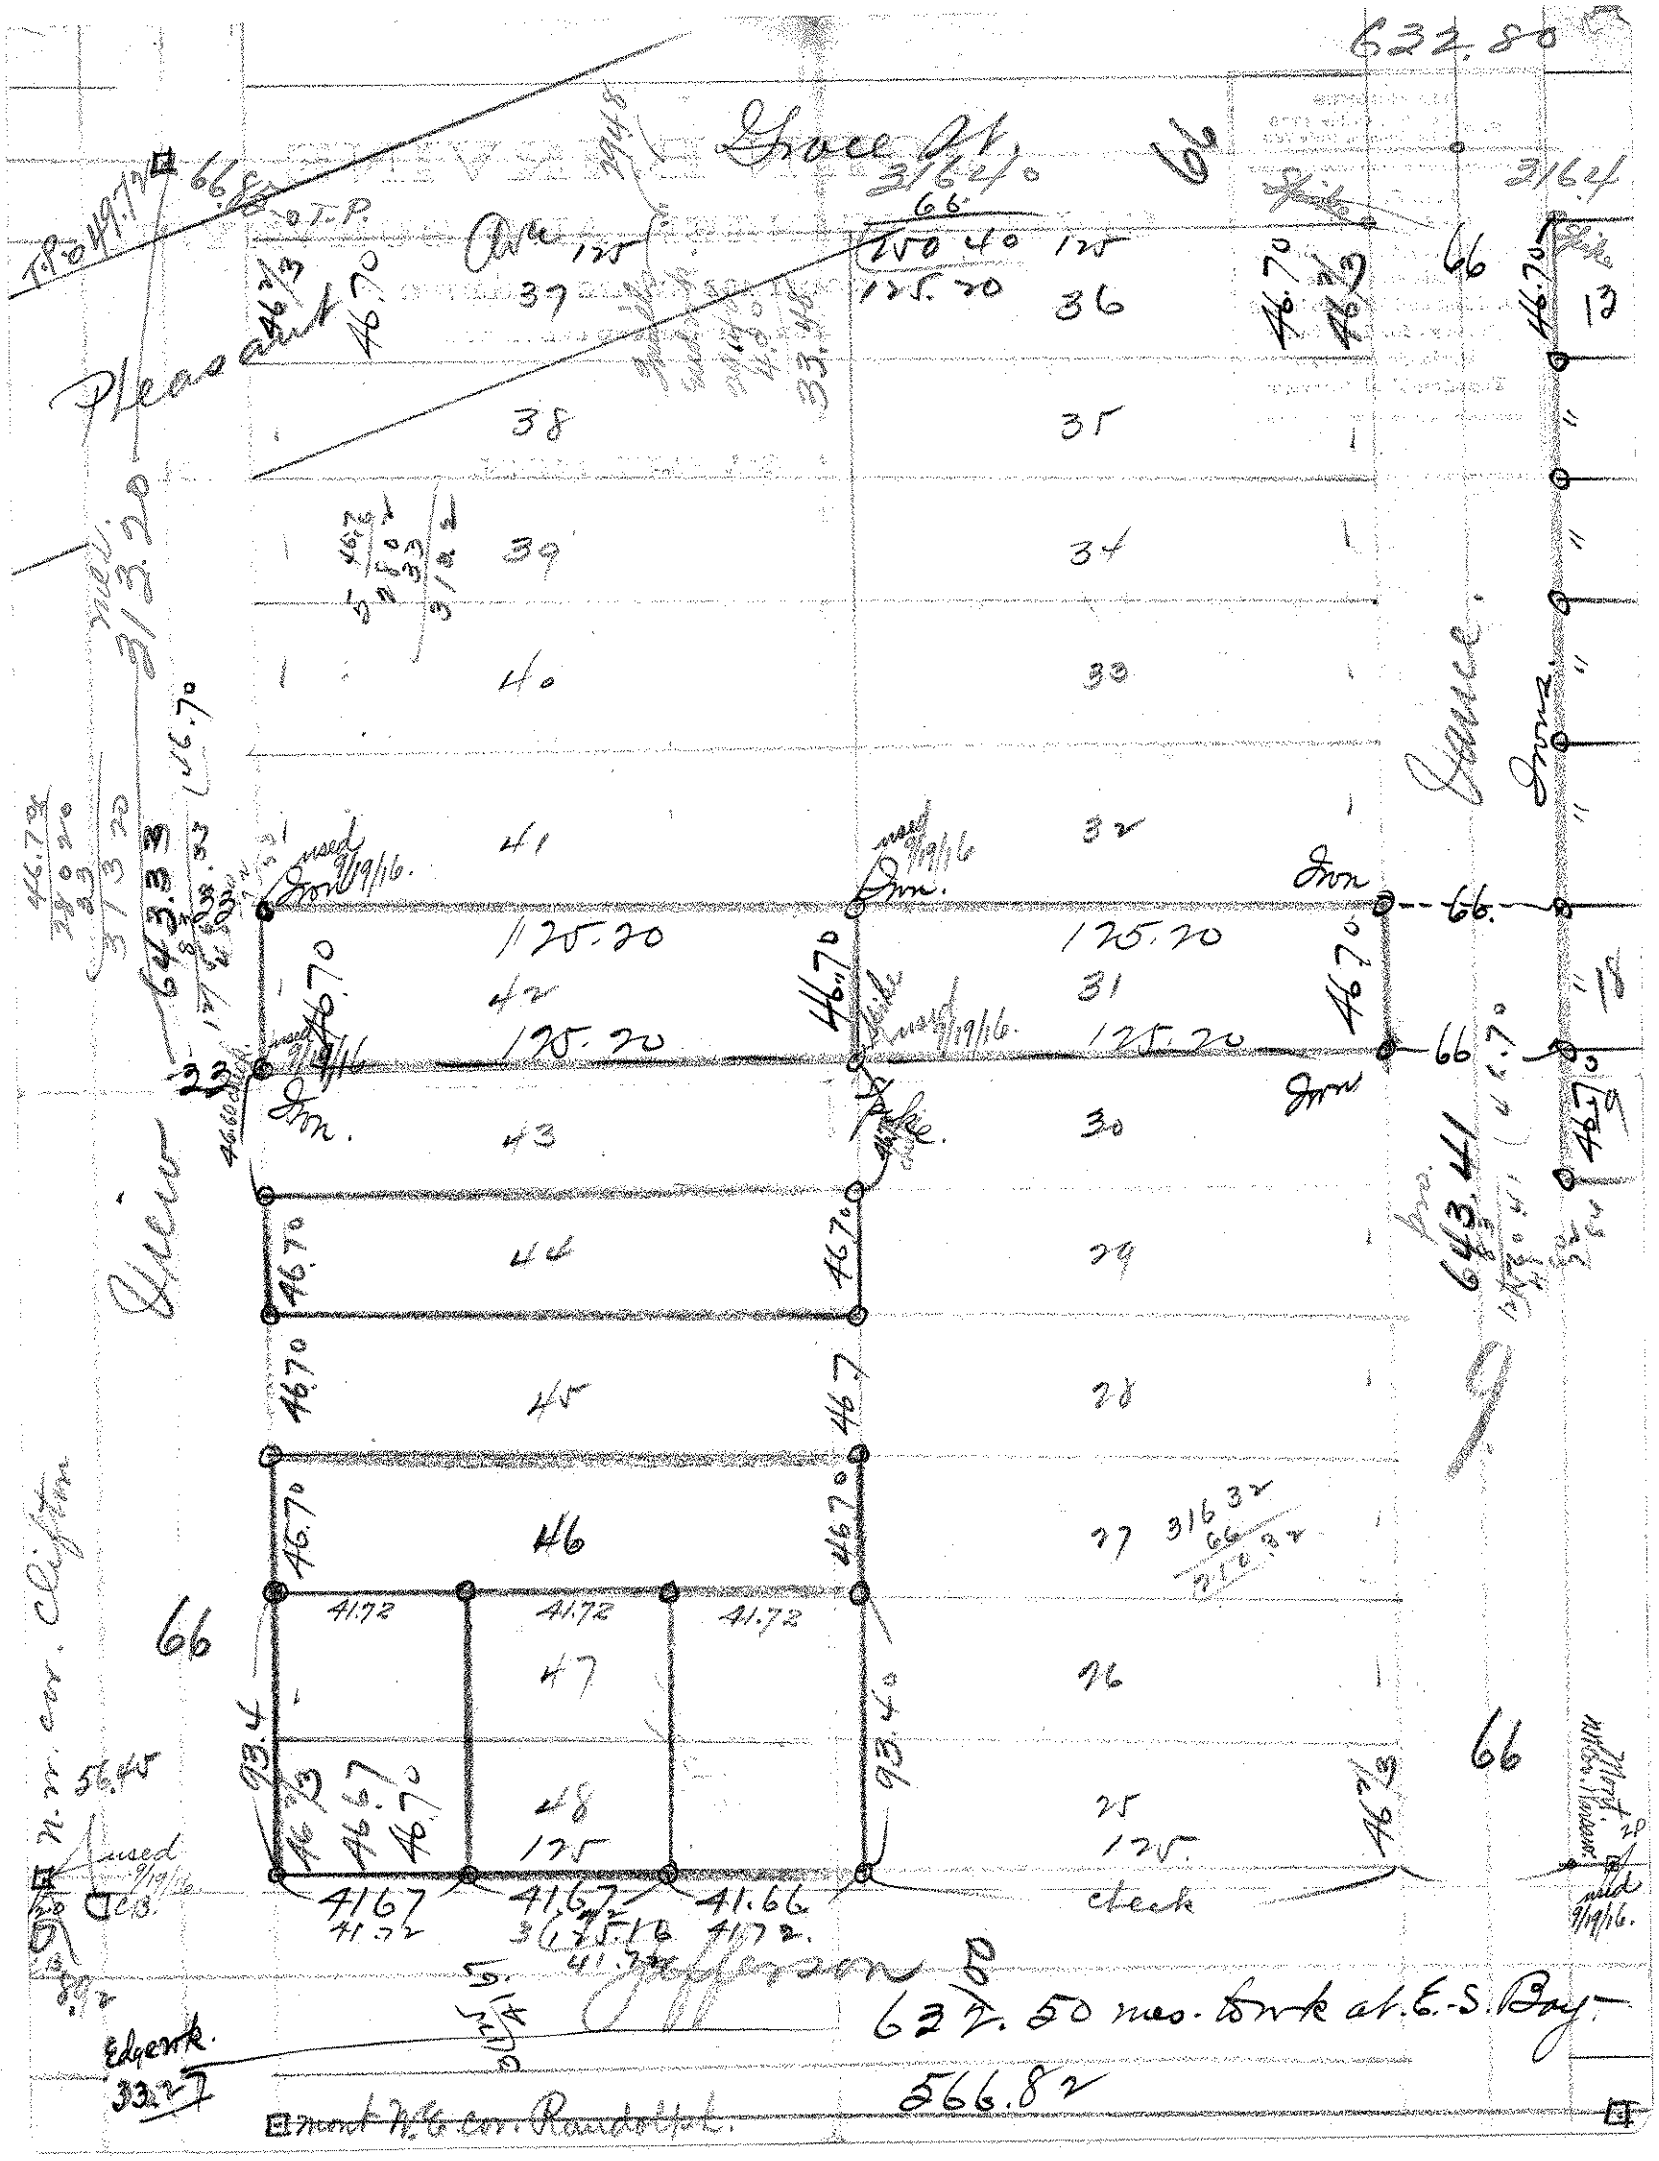
632.80
Grace St.
T.P. 44.7°
Pleasant
Alley
Grace
Queen
Jefferson
Edgewk.
Mount N.E. cor. Randolph
N.W. cor. Clifton
