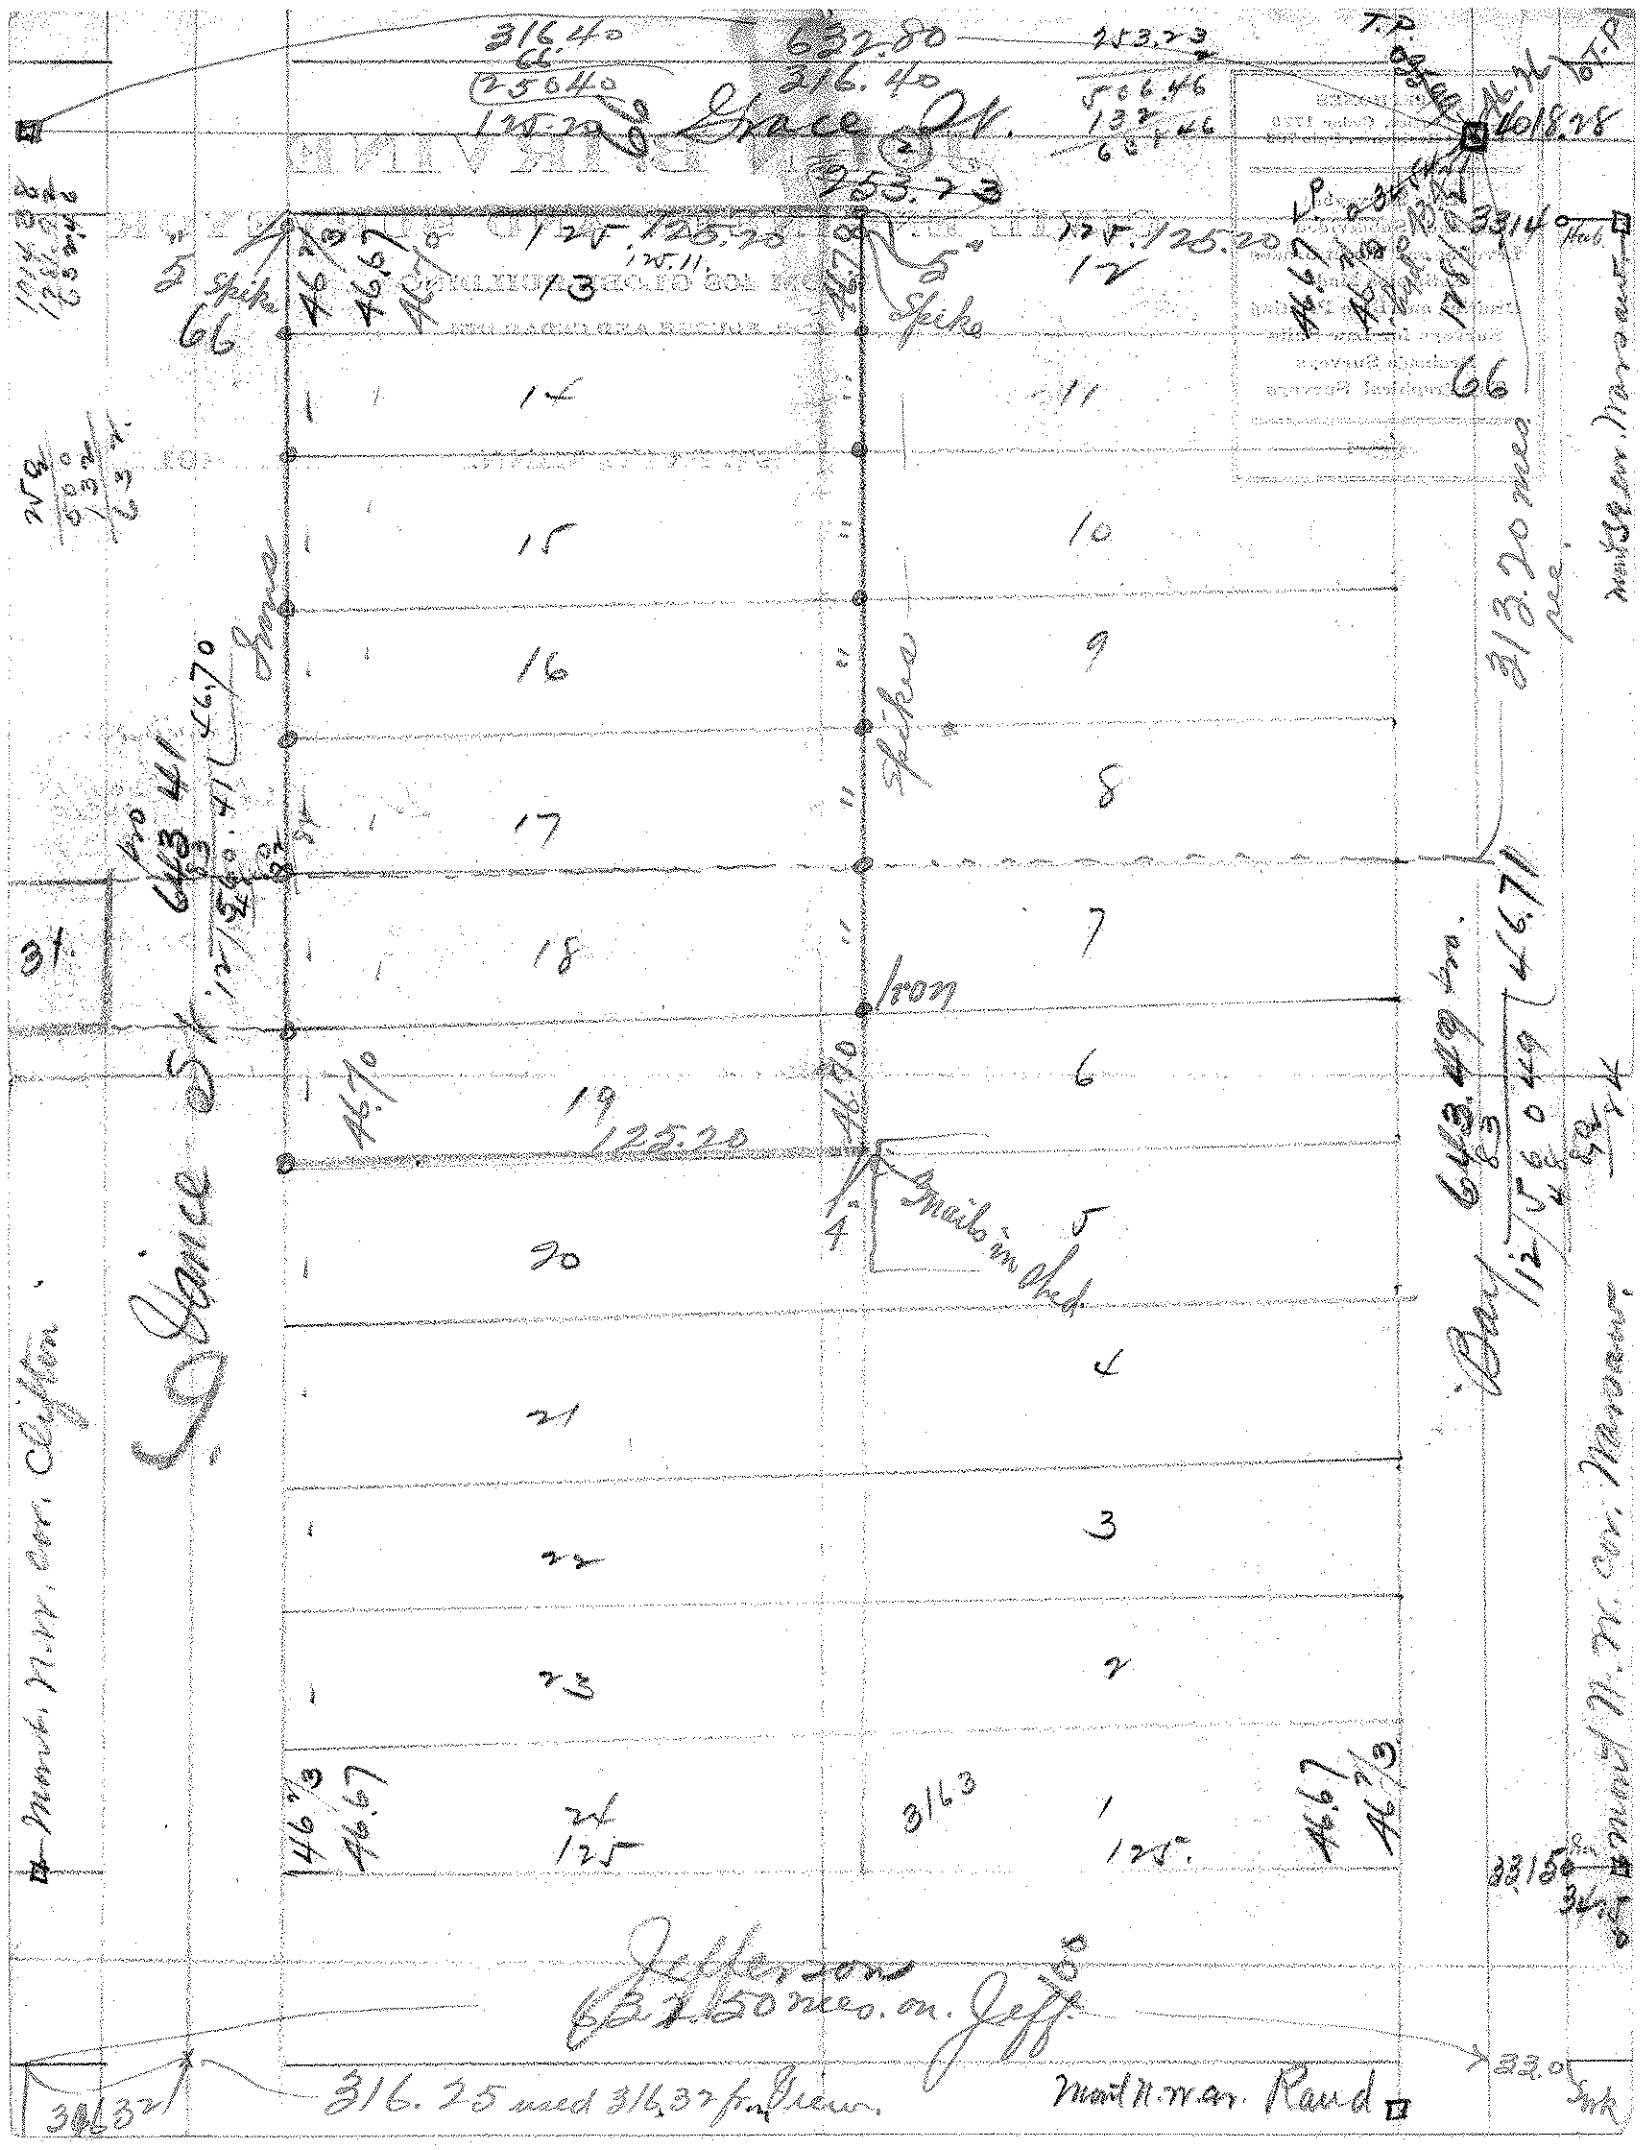
Grace St.
Grace St.
Mont. N.W. cor. Clifton
Mont. N.W. cor. Rand
Jefferson
Iron
Spike
Nail in Shed
Mont. N. 77. cor. Norman
316.40
632.80
253.23
955.23
125.20
125.11
313.20 mea.
316.25 mea 316.32 fm Plan.
632.80 mea. on Jeff.
33.0