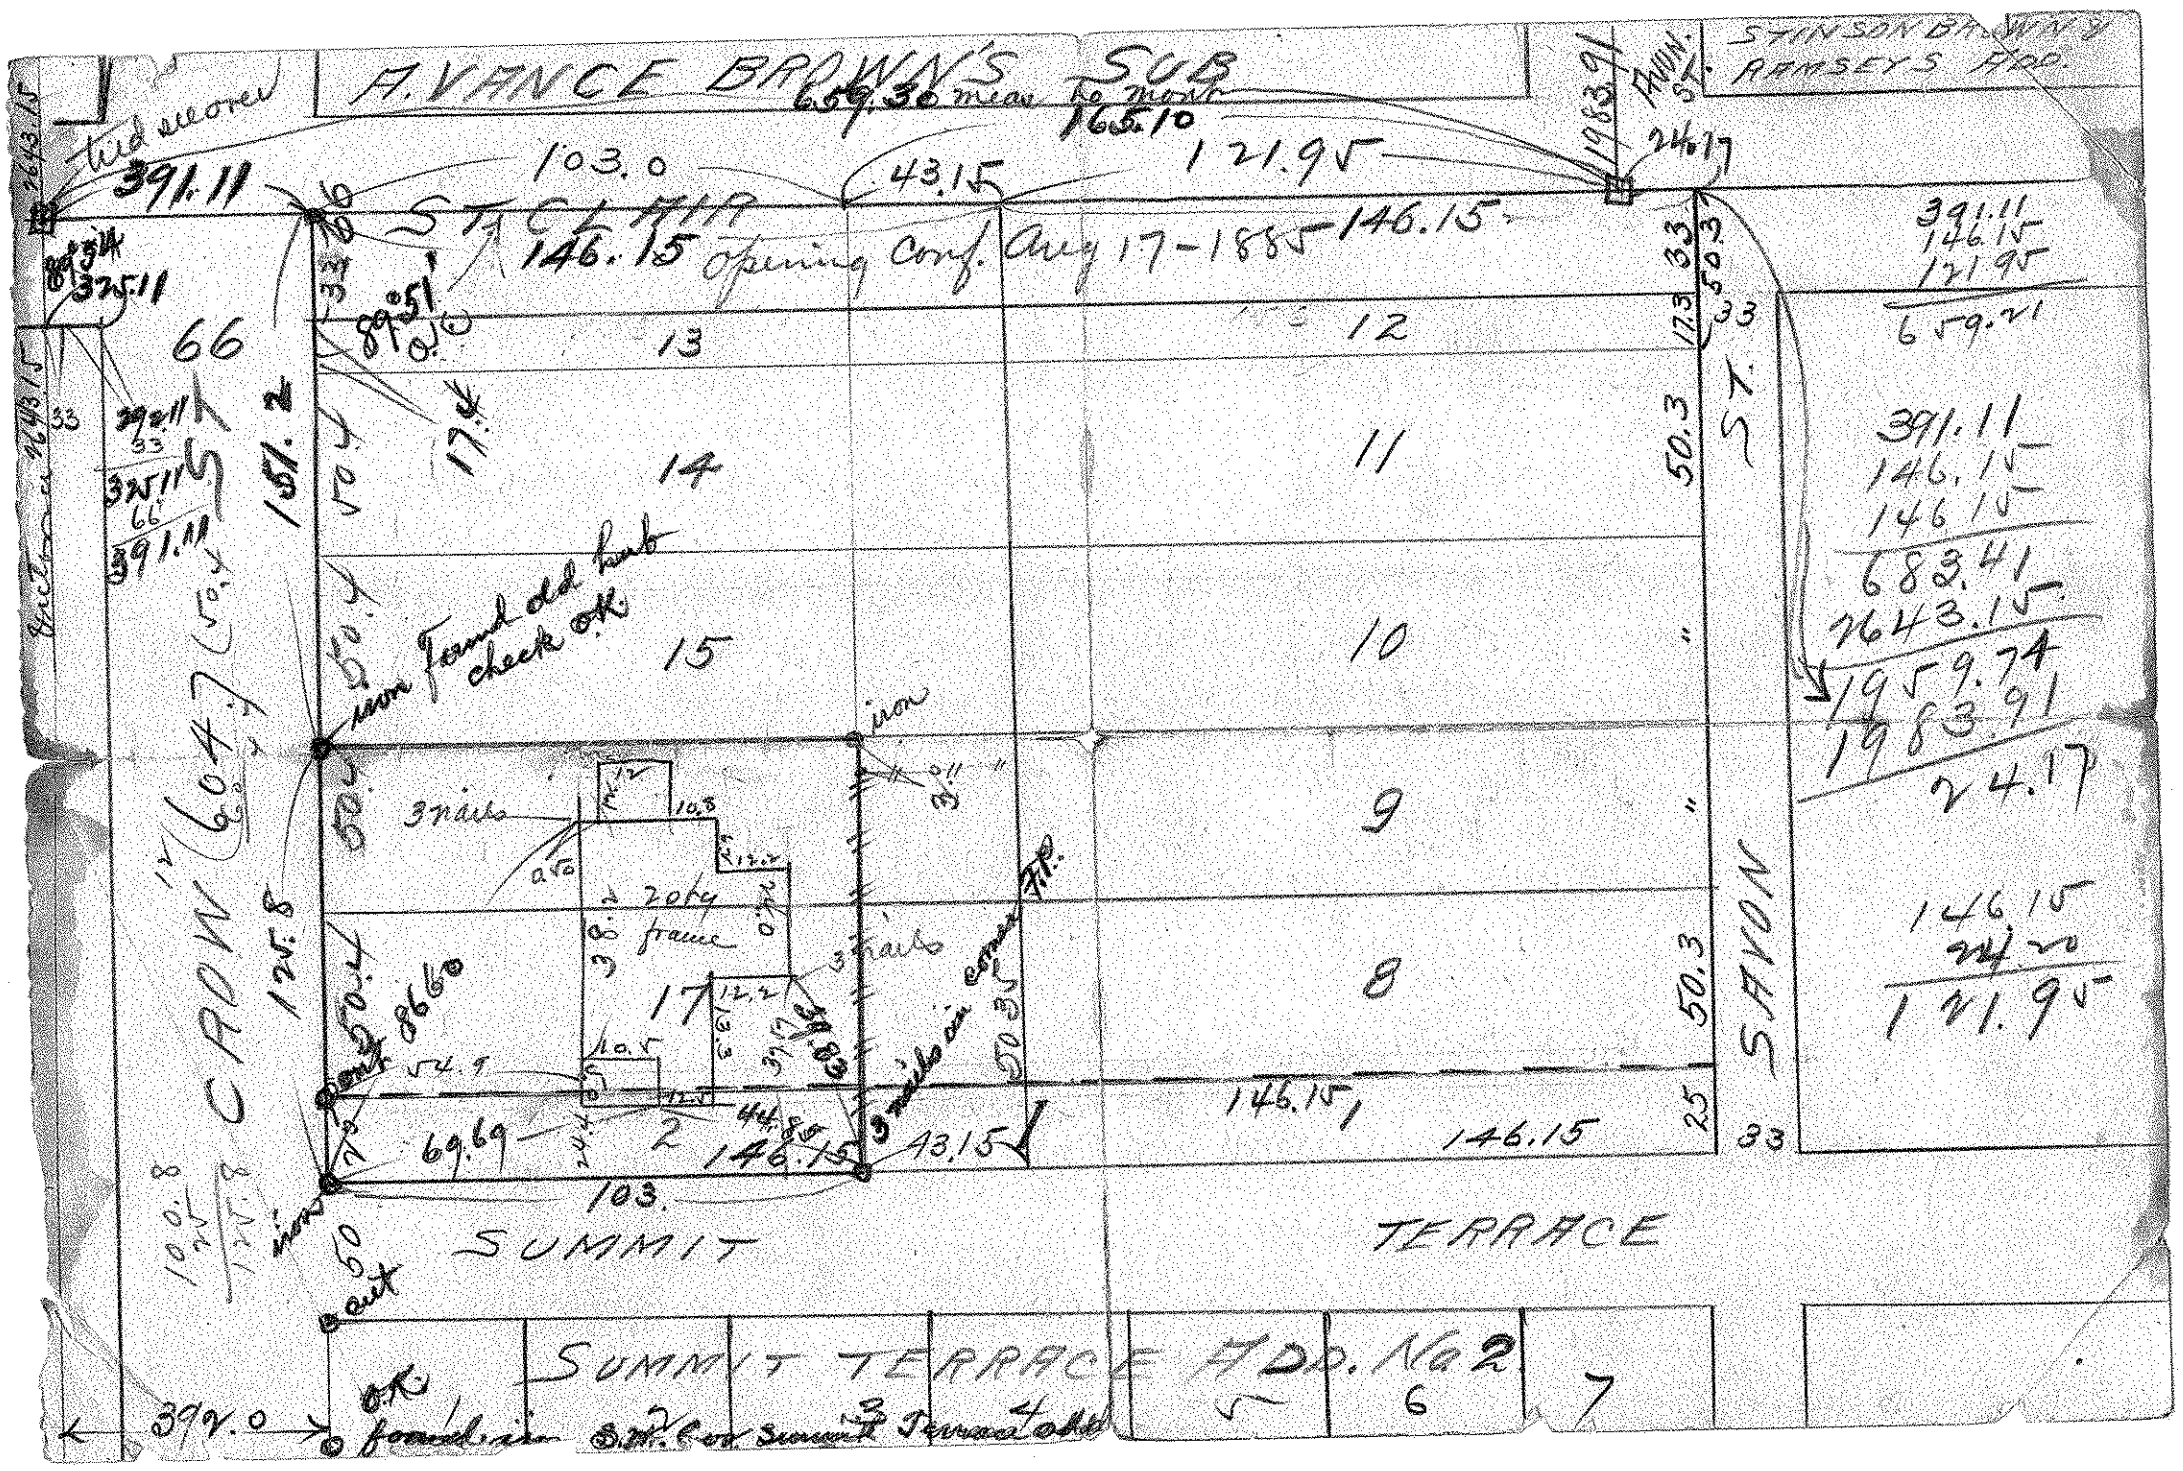
A. VANCE BROWN'S SUB
STINSON BROWN'S
RAMSEY'S ADD.
Found old bolt check O.K.
Opening Conf. Aug 17-1885
SUMMIT
TERRACE
SUMMIT TERRACE ADD. No 2
STINSON
ST.
AVN.
3 nails
3 stake in corner
Found old bolt
O.K. found iron S.W. Cor. Summit Terrace Add