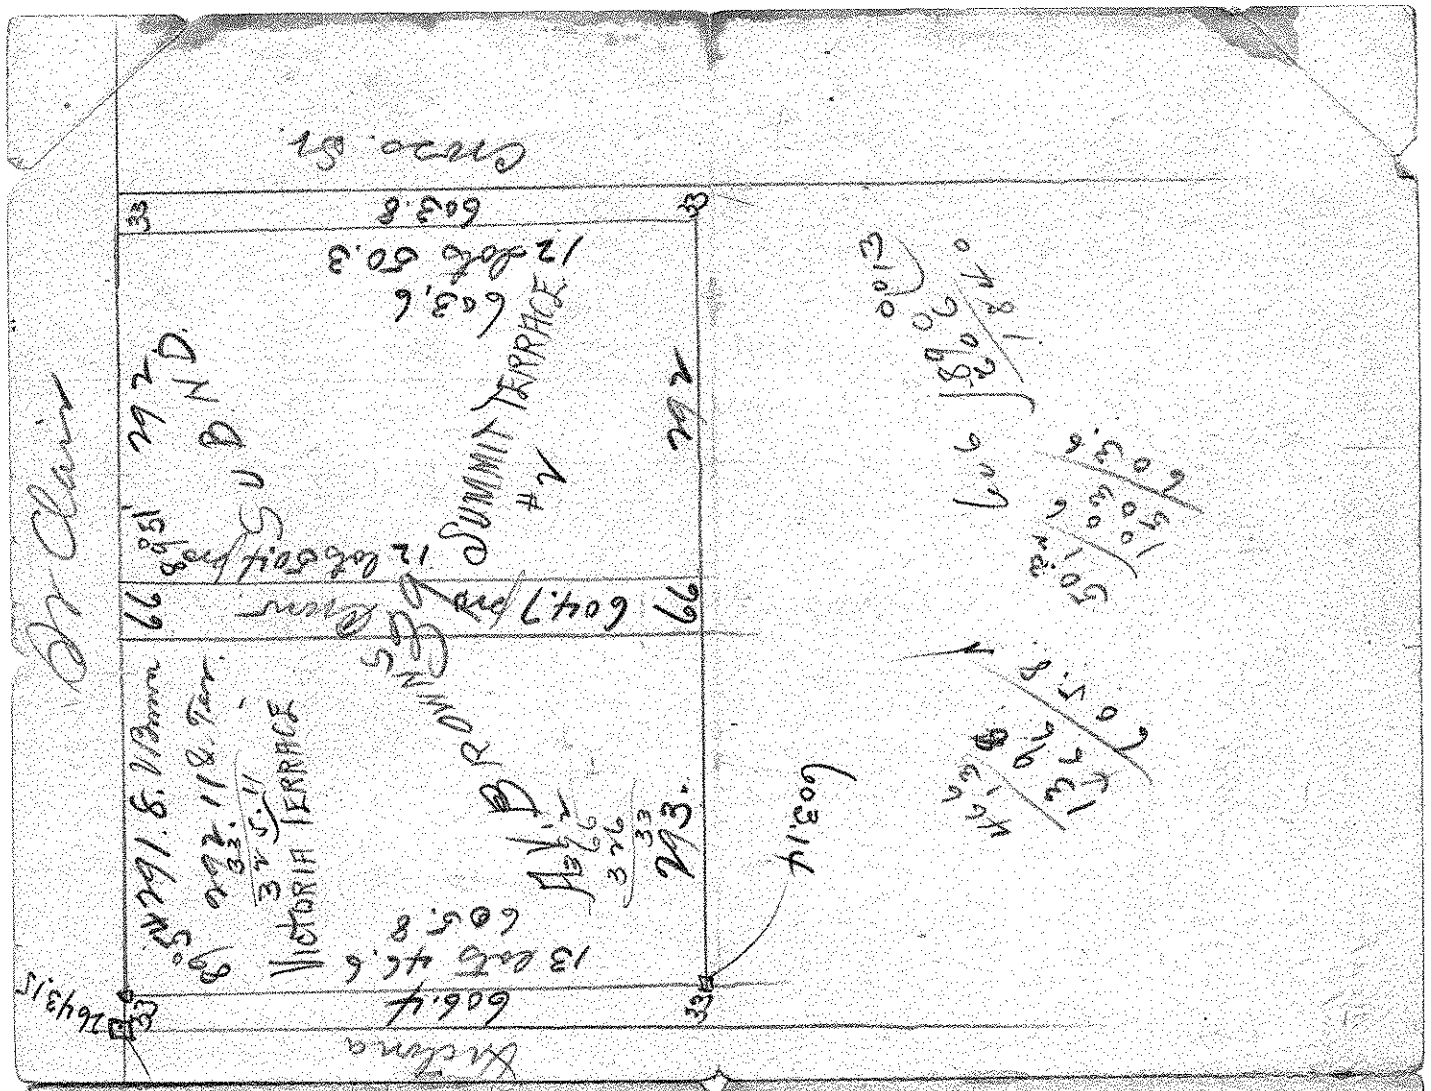

N 103 ft Lot 16 & 17 Blk 39
V Browns Sub Thomson
Brown & Ramsey Add
N 103 ft Lot 2 Blk 1
Summit Terrace Add
No. 2.
10.00
Mrs M. E. Conway
815 Summit Terrace
Dept 16-08