B.18 ✓

JOHN B. IRVINE

CIVIL ENGINEER AND SURVEYOR

ROOM 508 GLOBE BUILDING

FOURTH AND CEDAR STREETS

LOTS SURVEYED
LANDS SUBDIVIDED
LEVELING AND STREET GRADES
ESTIMATES MADE

DRAFTING AND BLUE PRINTING
SURVEYS FOR LAWSUITS
DRAINAGE SURVEYS
TOPOGRAPHICAL SURVEYS

NORTHWESTERN TELEPHONES { OFFICE, MAIN 2535-J
RESIDENCE, DALE 783-J2

ST. PAUL, MINN. _____ 190__
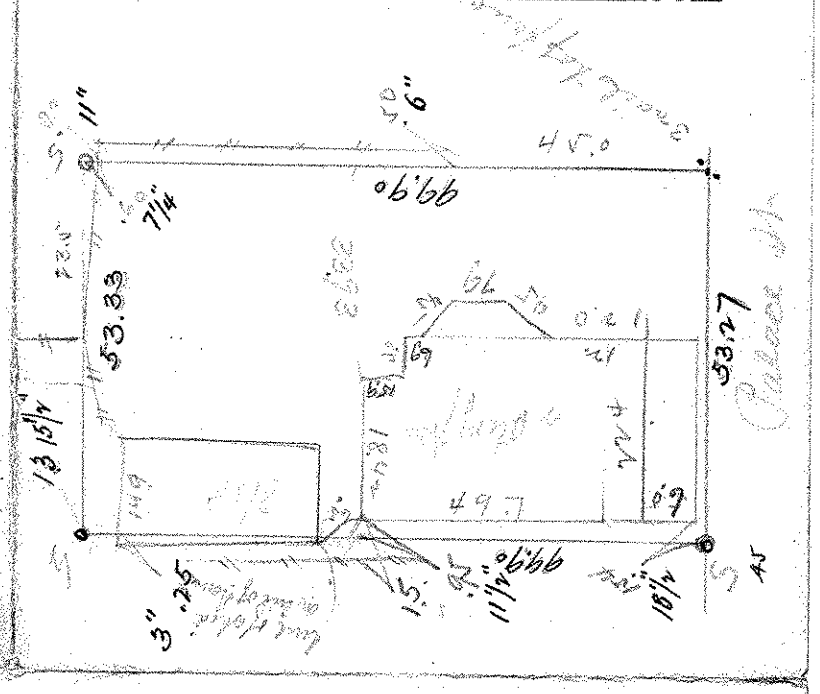
Lot 11 Thos. Dalys Sub.
of Blk 18. O.T. S.R. and
Jos. Oladek.
633 Palace St.
June 23-06