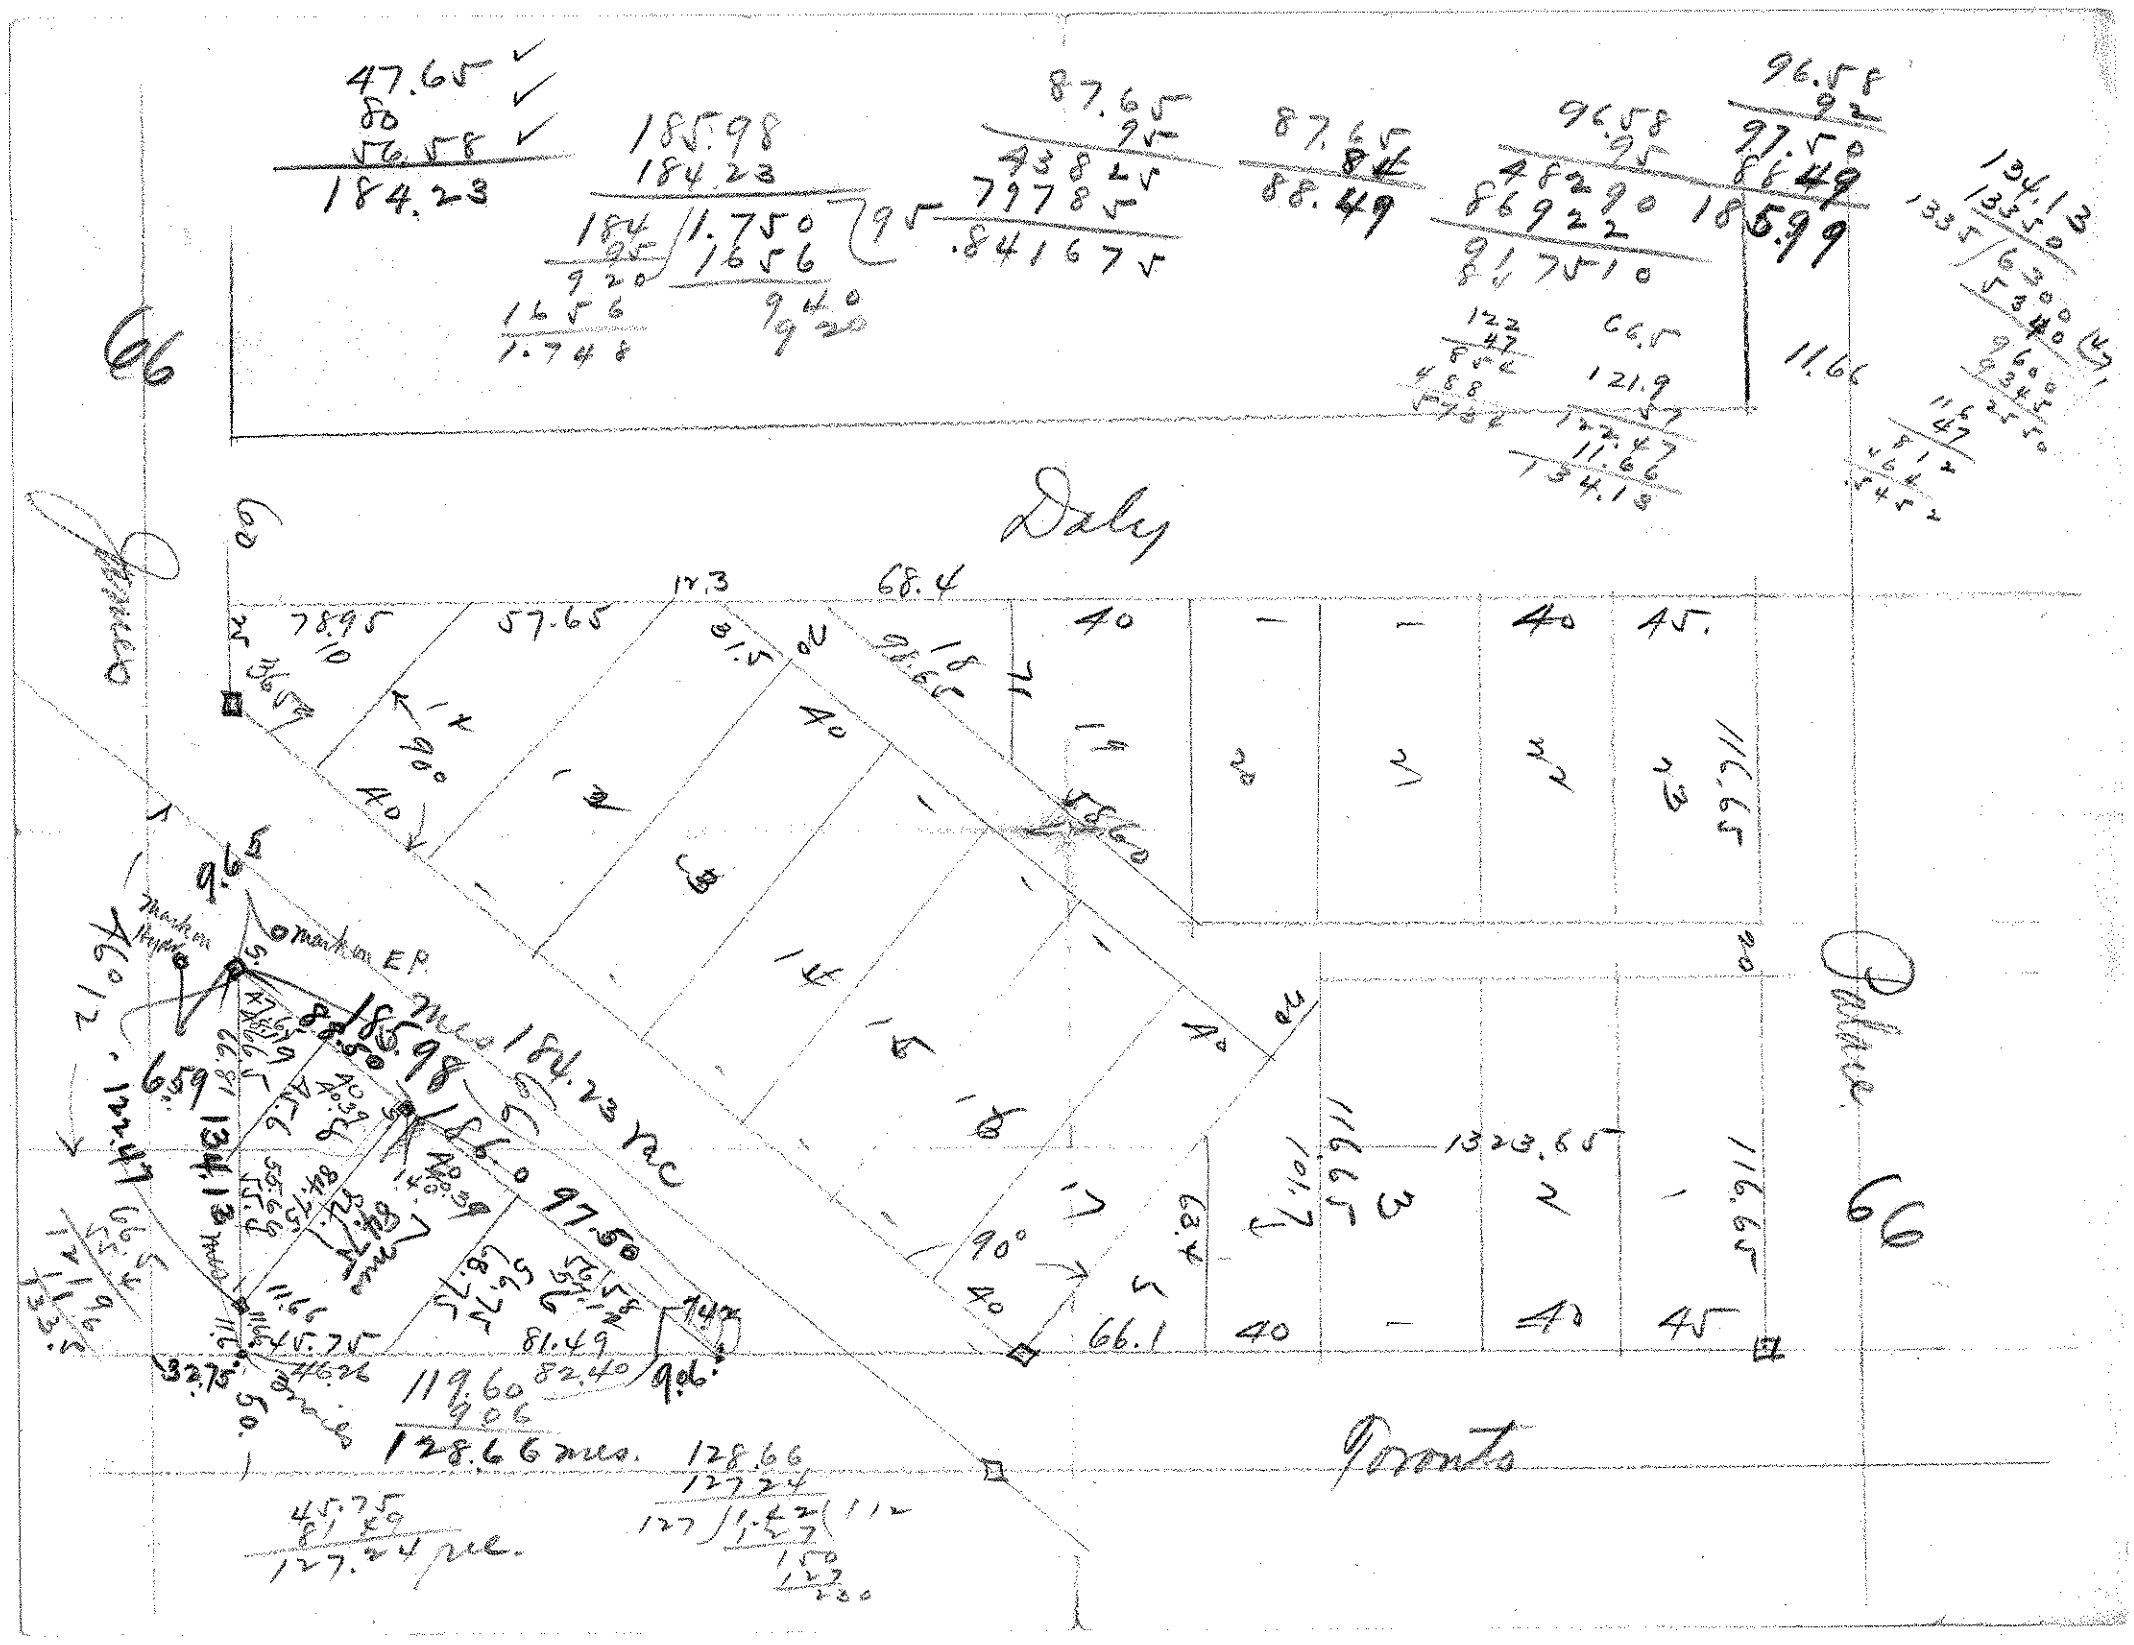
Daly
Mark on Rock
Mark on E.P.
