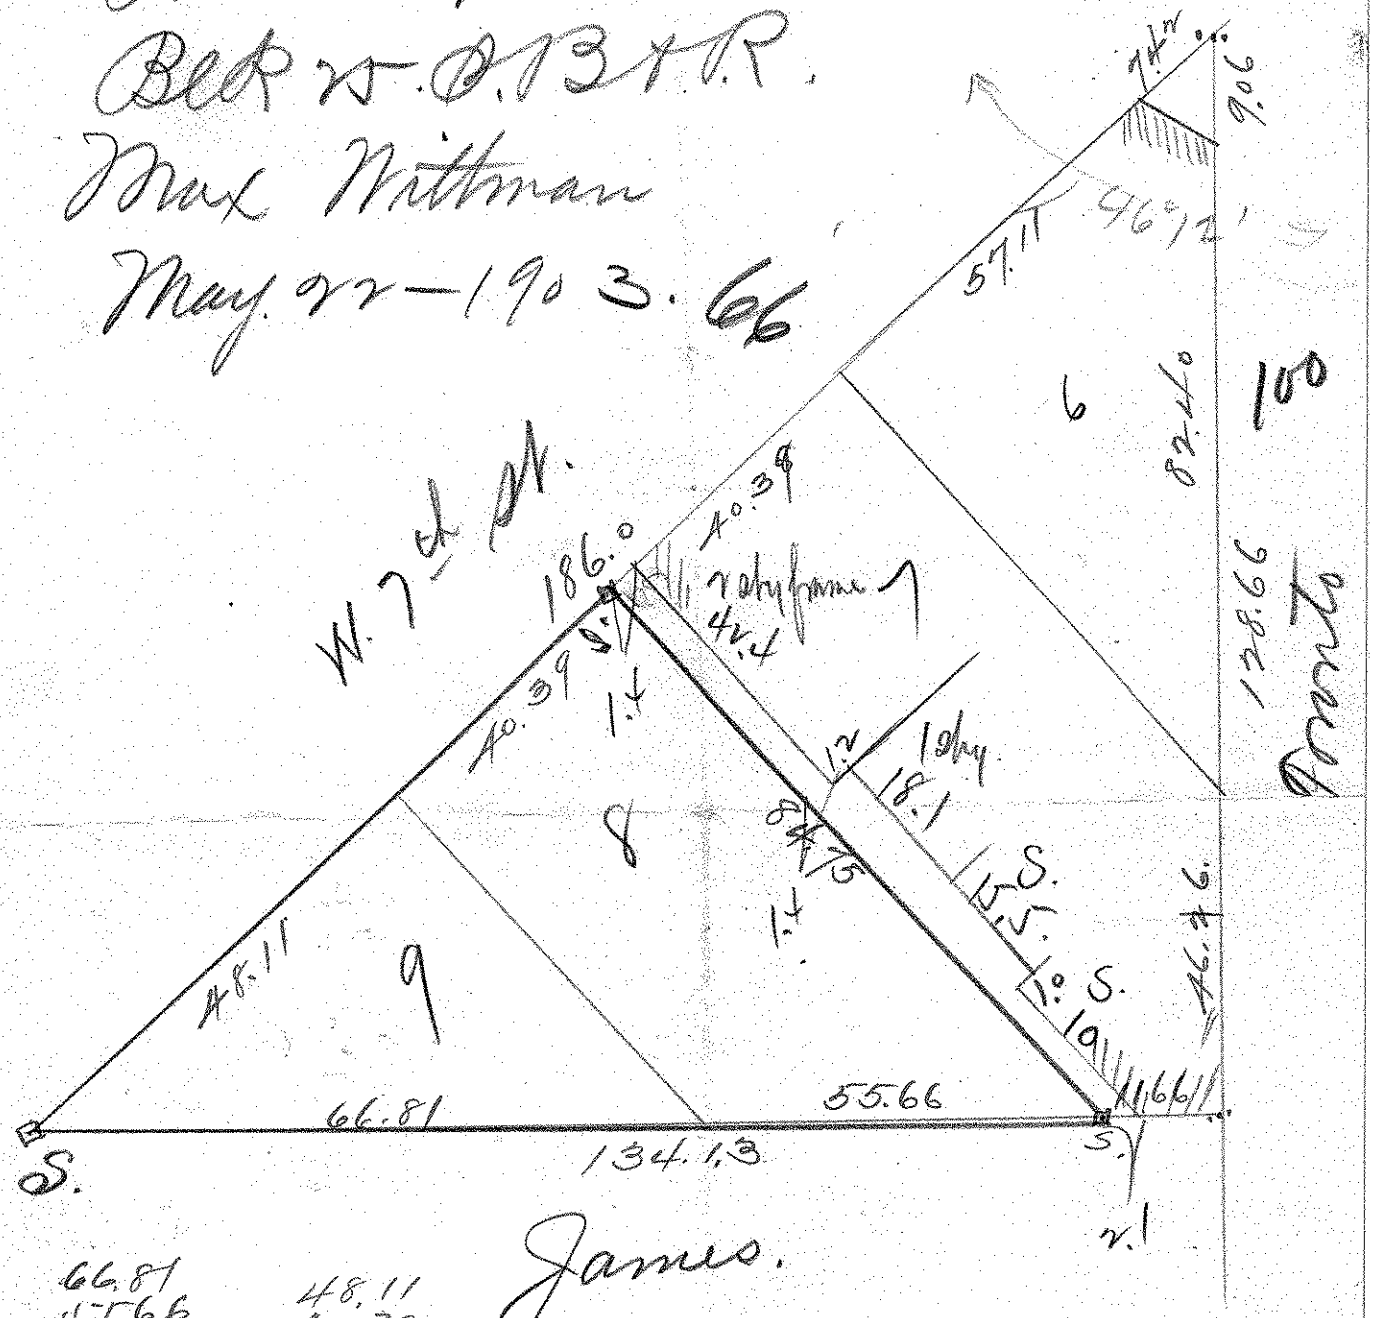Lots 8 + 9. Stevens Sub.
Blk 25. D. 13 T. R.
Max Nittman
May 22 — 1903. 66