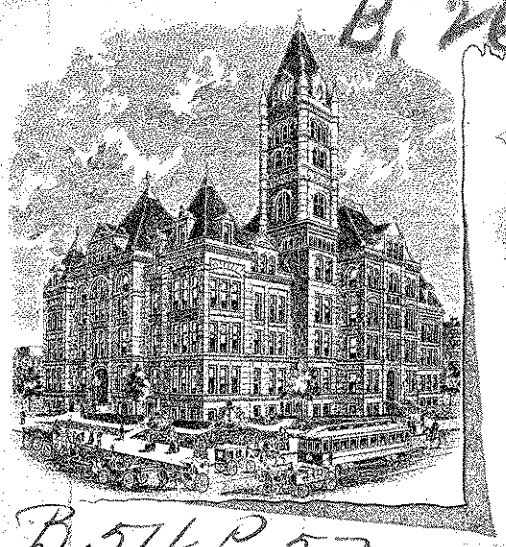

B. 26 ✓

RAMSEY COUNTY
OFFICE OF
COUNTY SURVEYOR

JOHN B. IRVINE,
SURVEYOR
ROOM 16 COURT HOUSE.

St. Paul, Minn. 190

B 54 P. 57
Lots 3-4-5-16-17-18
Ramsey's Add Blk 26
Thurston Rd & Ramsey
May 21 '03
Louis T. Schultz

95 the Louis T. Schultz
B. 54 P. 57