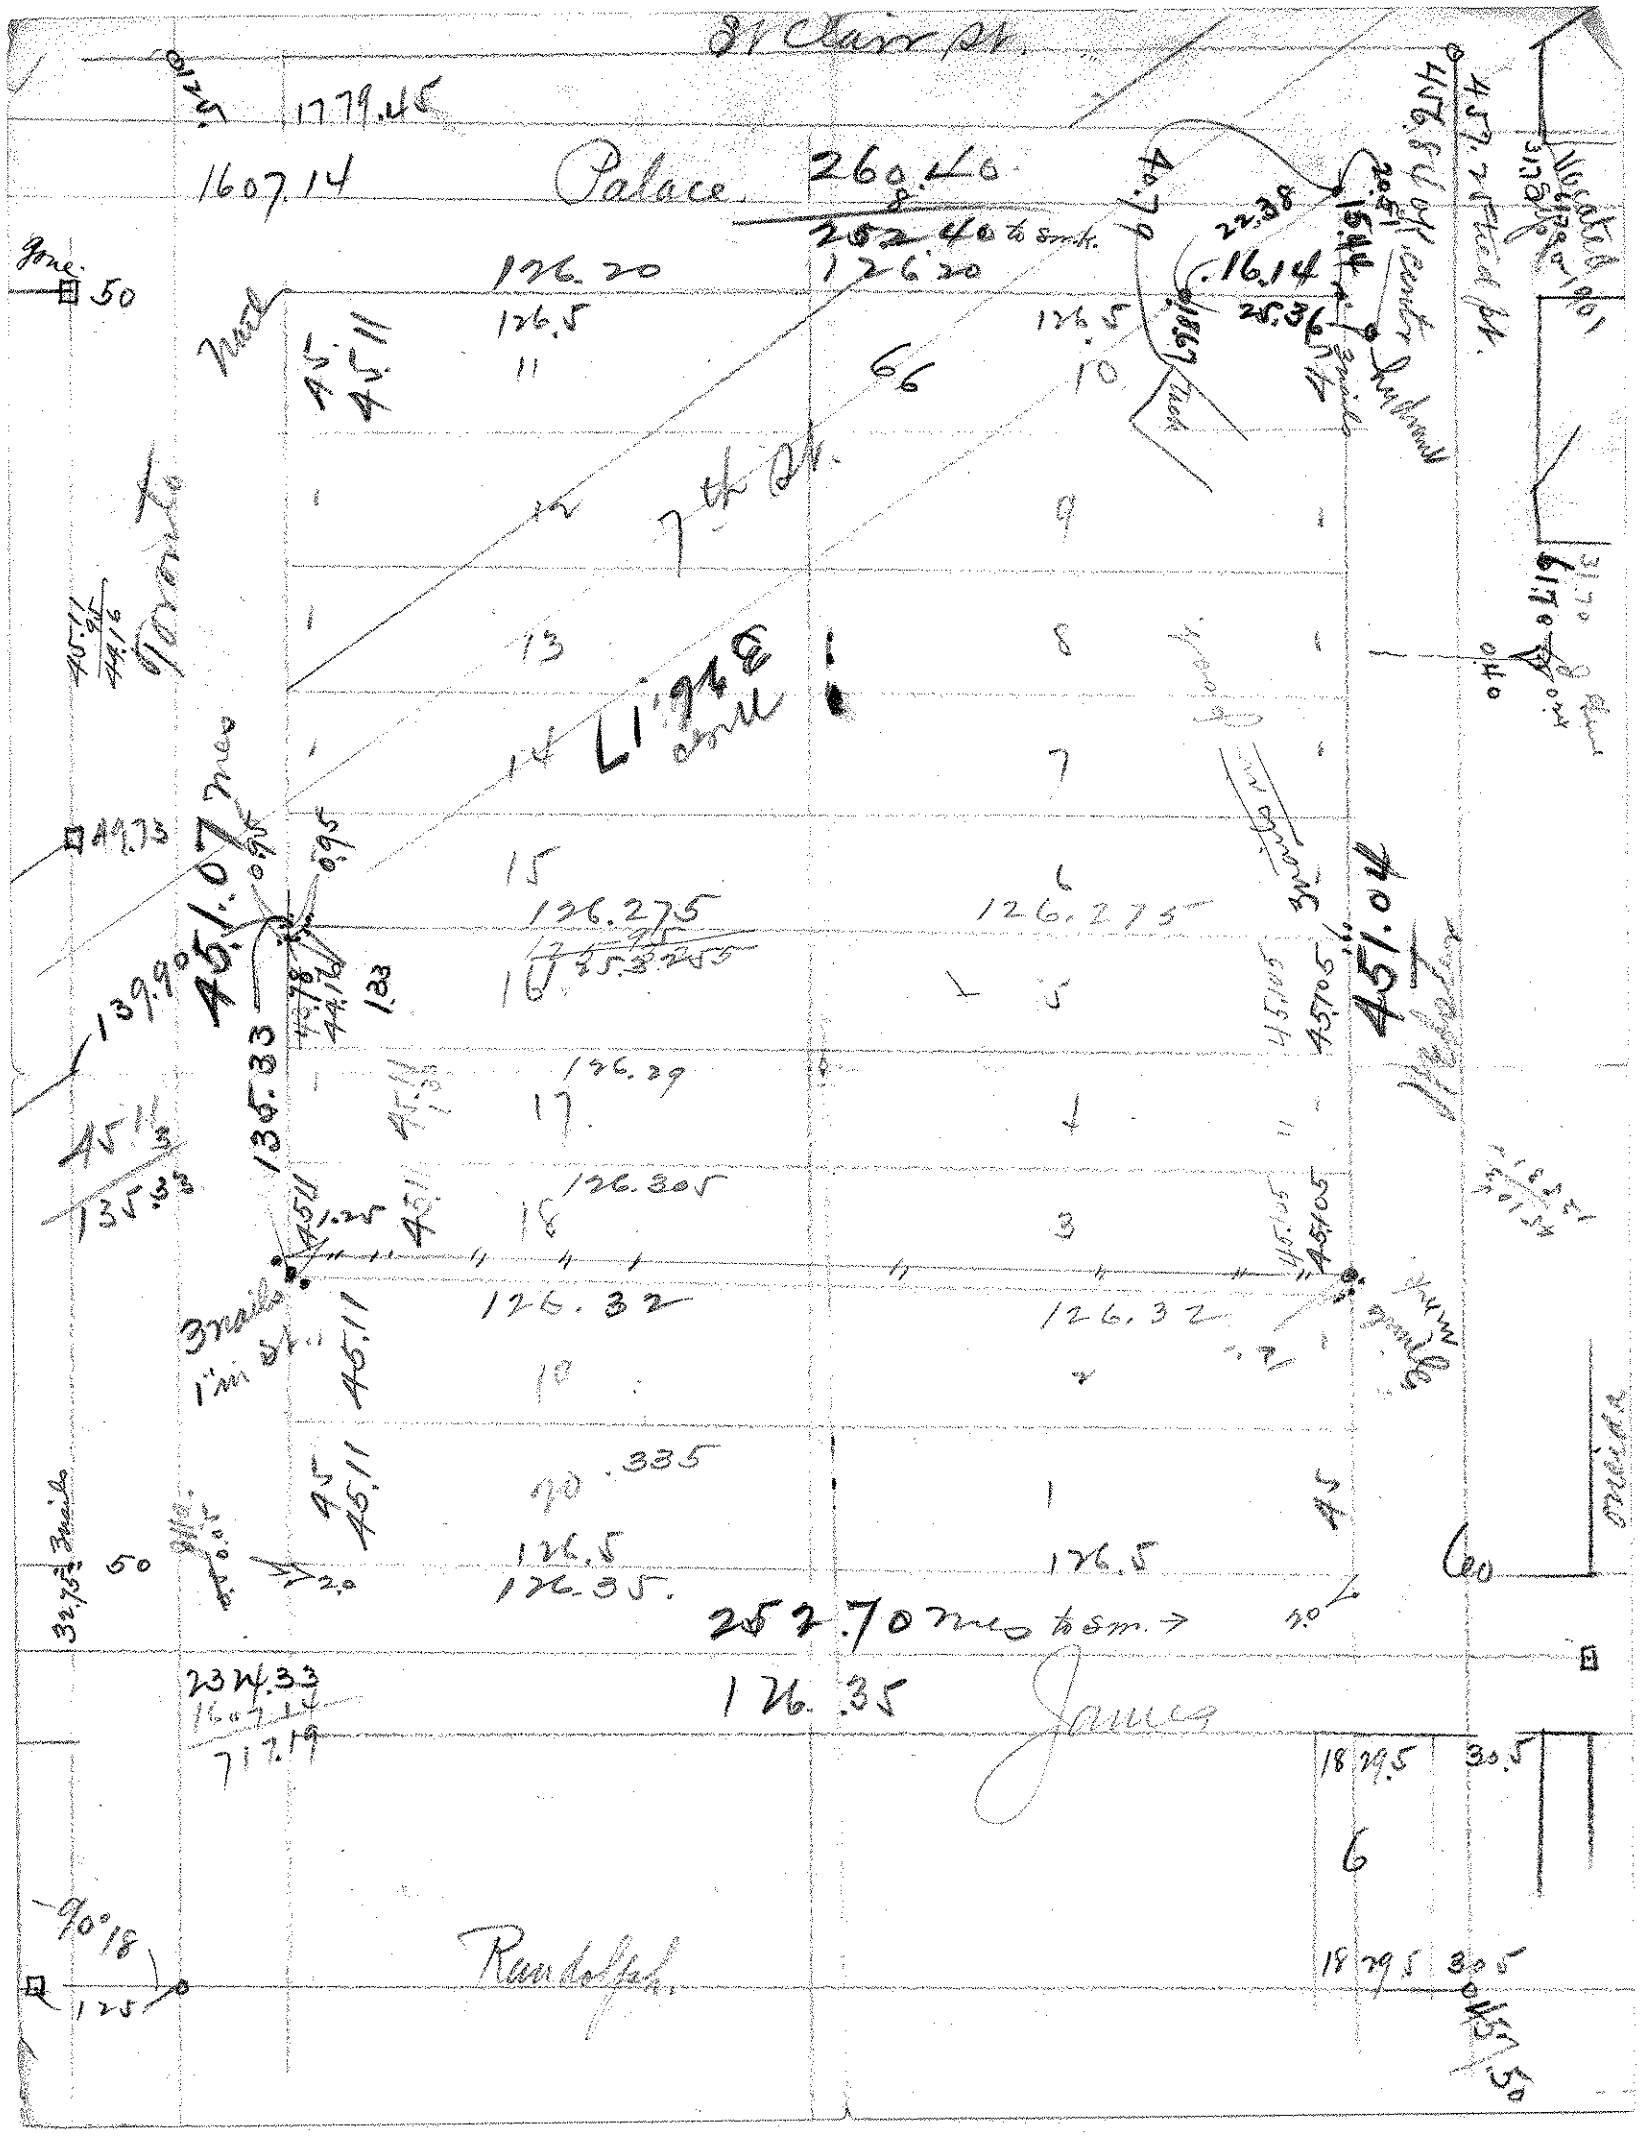

St Clair St.
1779.45
1607.14
Palace
260.40
252.40 to sm.
126.20
126.20
126.5
126.5
11
66
10
12
9
13
8
14
7
15
6
126.275
126.275
16
5
17
4
126.29
18
126.305
3
126.32
126.32
19
2
20
.335
1
126.5
126.5
126.35
252.70 mes to sm.
126.35
James
Randolph
Toronto
7th St.
Gone
50
49.73
139.90
45.11
135.33
451.07 mes
451.04
3 nails
1" in St.
32.75 3 nails
50
2324.33
1607.14
717.19
90°18
125
18 29.5
30.5
6
18 29.5
30.5
457.50
Nicolet