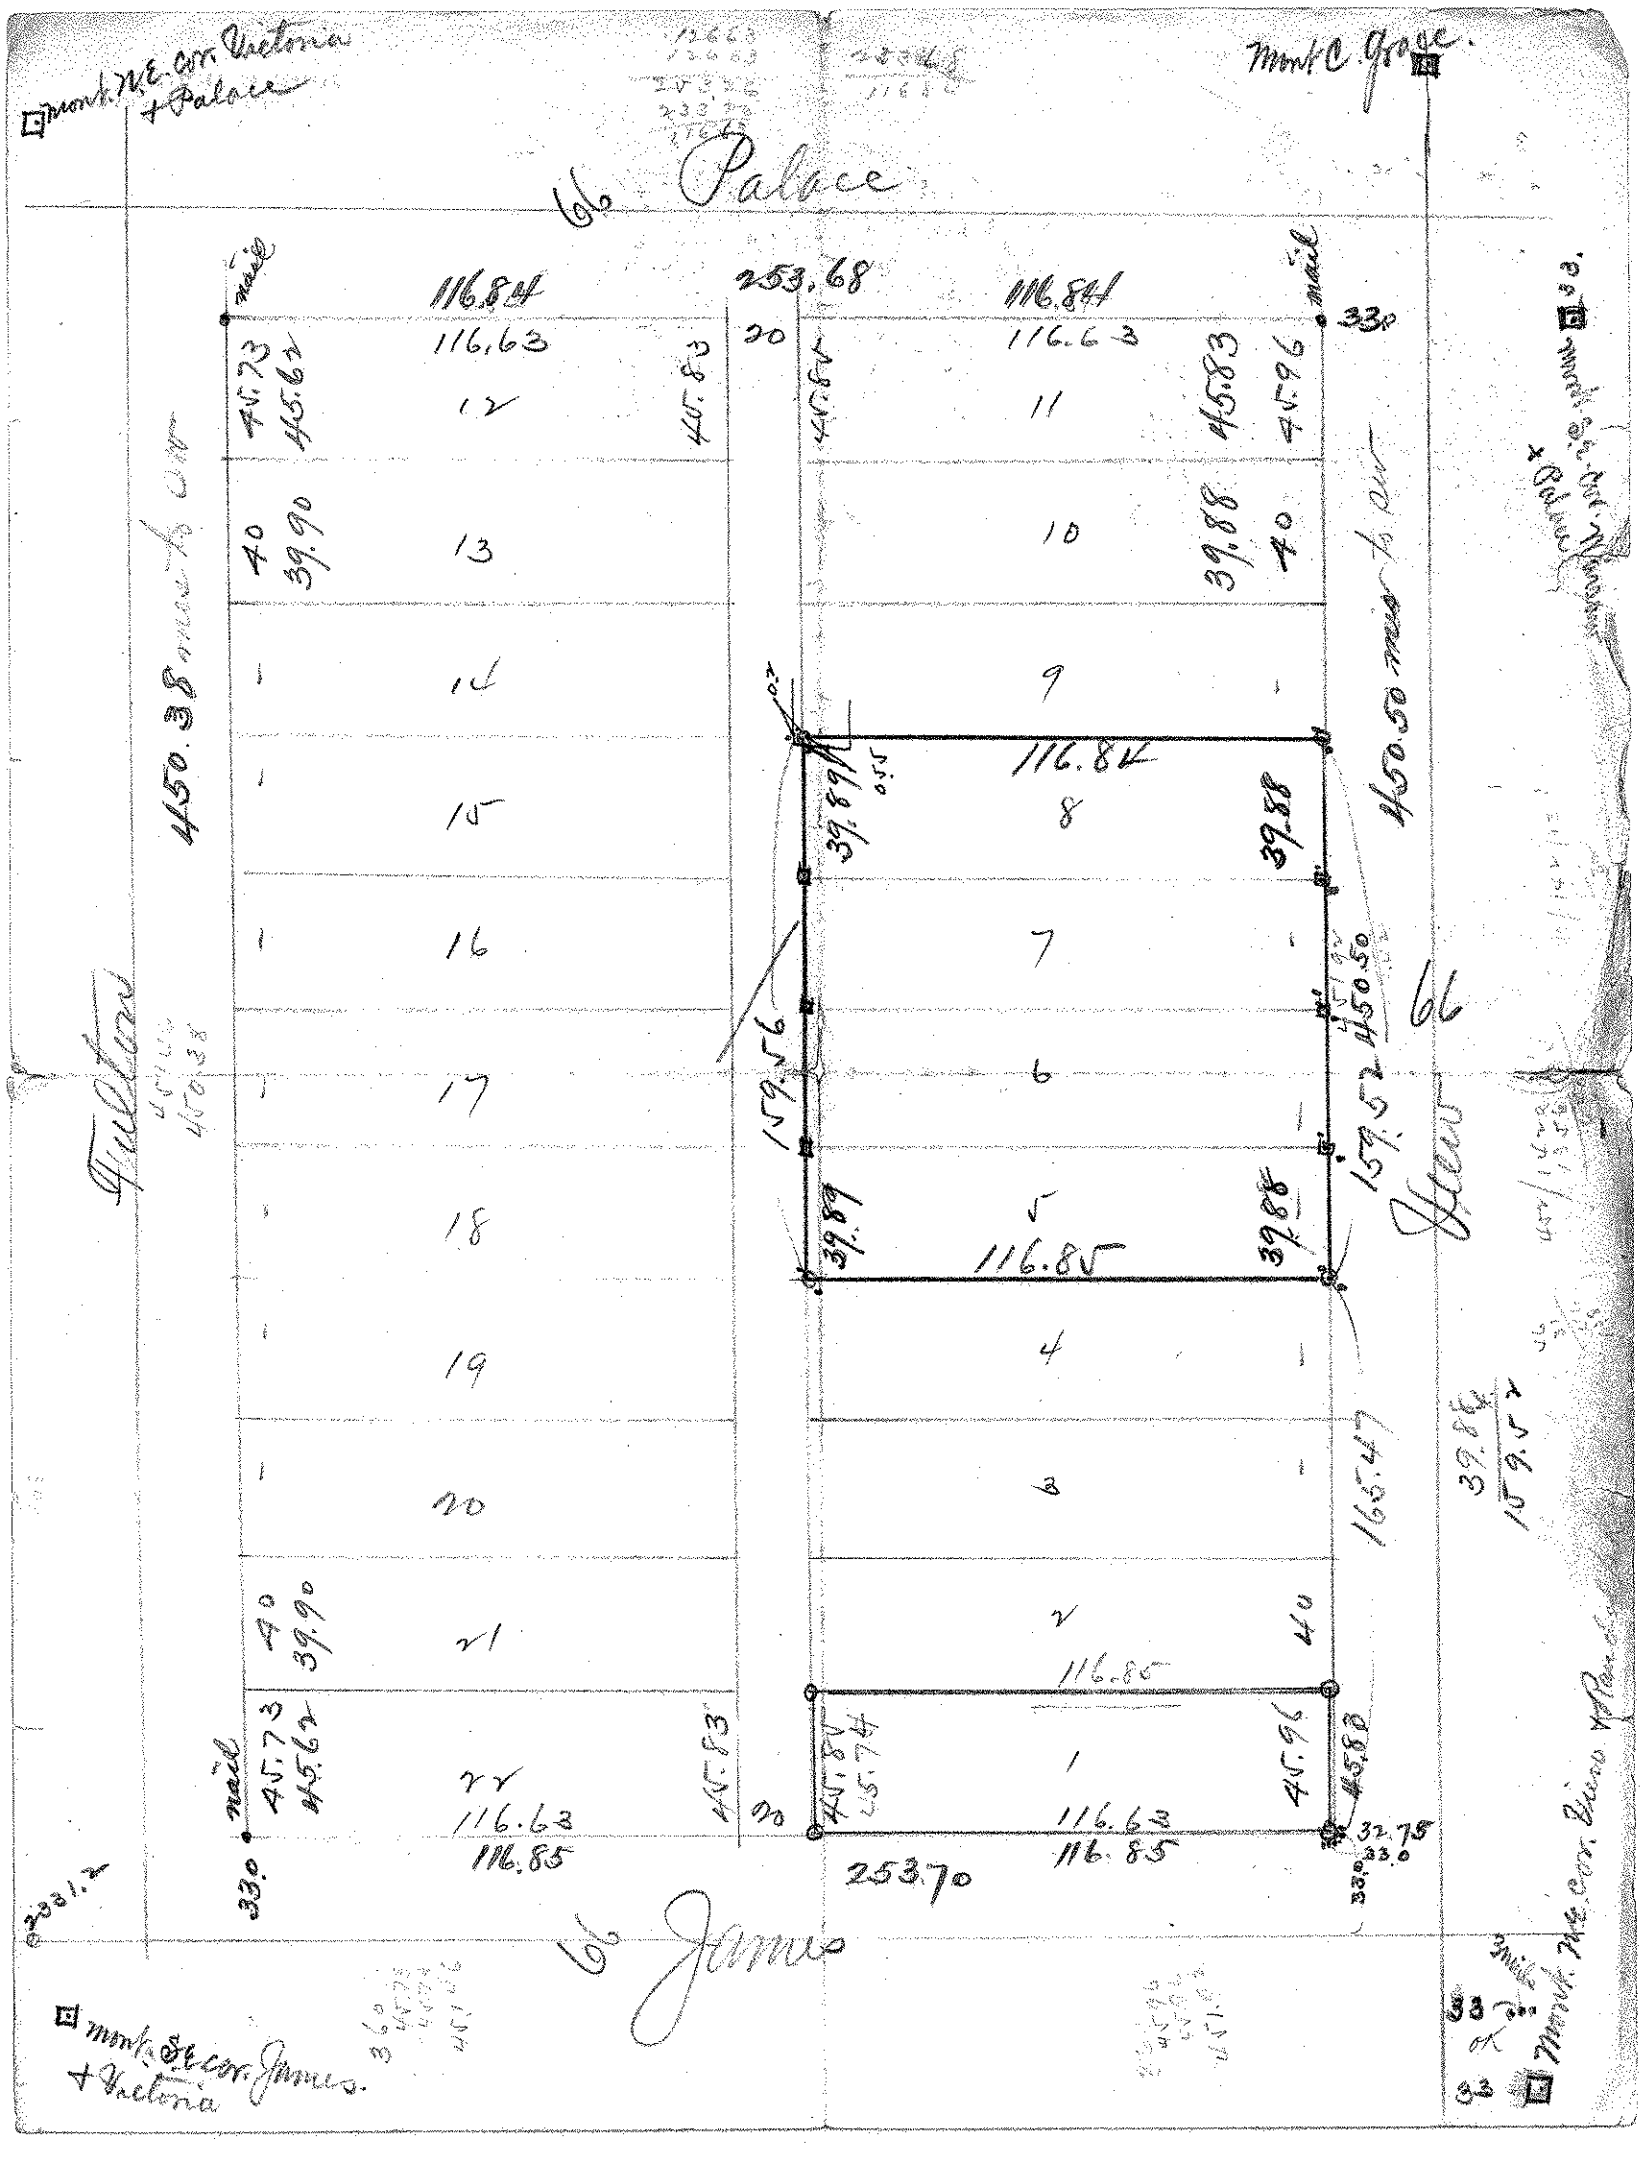

Mont. N.E. cor. Victoria + Palace
Mont. C. Grace
66 Palace
116.84
253.68
116.84
116.63
116.63
12
11
13
10
14
9
15
8
16
7
17
6
18
5
19
4
20
3
21
2
22
1
116.85
116.85
116.63
116.63
116.85
116.85
253.70
450.38 mis to cor
450.50 mis to cor
159.56
159.52
165.47
450.50
39.89
39.88
39.89
39.88
39.88
39.90
39.90
45.73
45.62
45.83
45.85
45.96
45.83
45.74
45.83
45.96
45.83
45.73
45.62
45.83
45.85
45.74
45.83
45.96
45.83
33.0
32.75
33.0
33.0
33.0
33.0
66 James
Fulton
Hess
Mont. S.E. cor. James + Victoria
Mont. N.E. cor. Victoria + Palace