Lot 4 Blk 31
Thos Dale's Sub
D. 13 Pcs
Mch 7-1901
Frank Hasler
97 & 77 ft of

LOT 19 Blk 31
Thos Smith.
N 7th & Cleveland
Dupl. 21-07
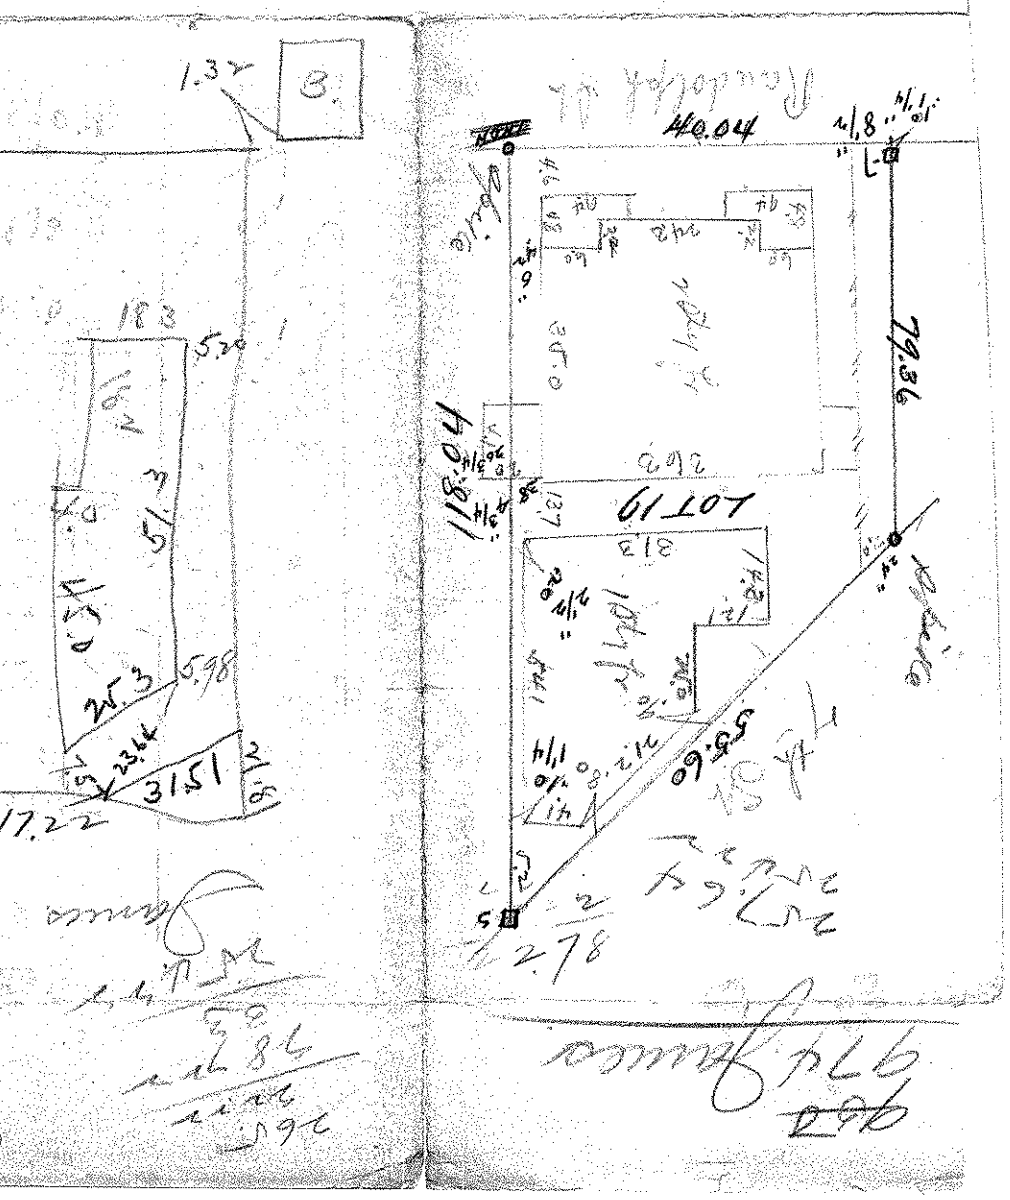
B. 45 P. 23