

Lot 19, Blk 32 ✓
 A.G. Brown's sub of
 D.B. Ramsay's add


May 2 1905
 Schleck Bros
 991 77th St
 call on way out

West 40 ft of Lot 19 Blk 32

May 2nd 05
 see Mch. 18-07

Winkler
 Wray Palace

lot 20 Mch. 18-07
 Round

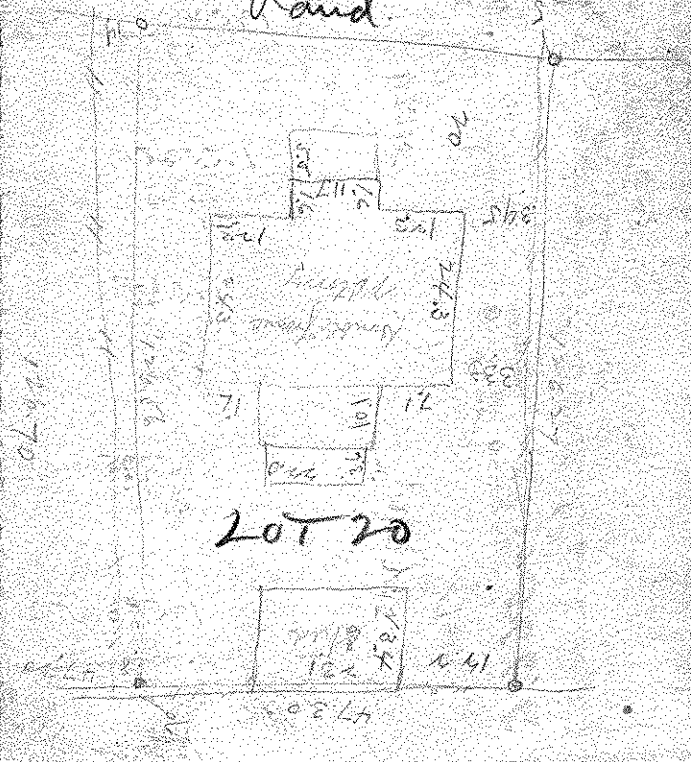

LOT 20

9639.42
 2331.20
 308.92
 242.22

49215
 20030
 47215
 16658

47215
 47215
 26095


964797
 224103
 273.64
 66

257.64
 241.22
 3.8
 3.8

457.64
 3.8
 253.79
 3.8

253.79
 246.08
 249.96
 257.64

5004274
 2533388
 246.08
 5004274

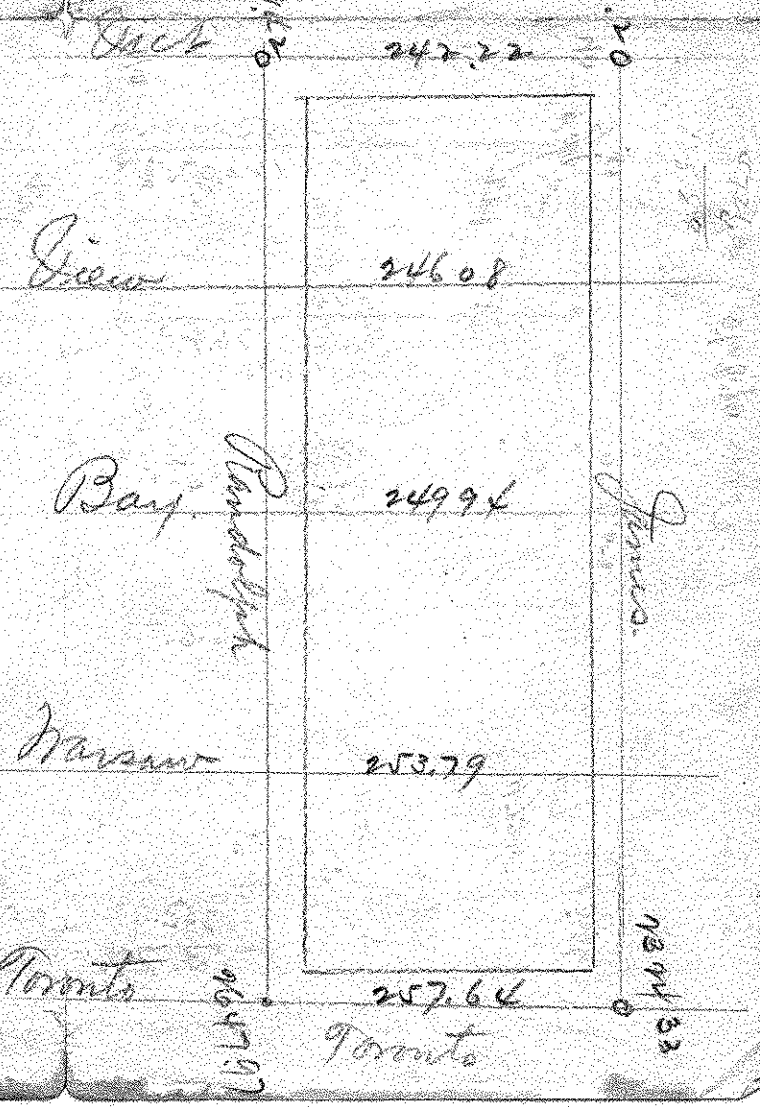

View

Bay

Toronto

Toronto



