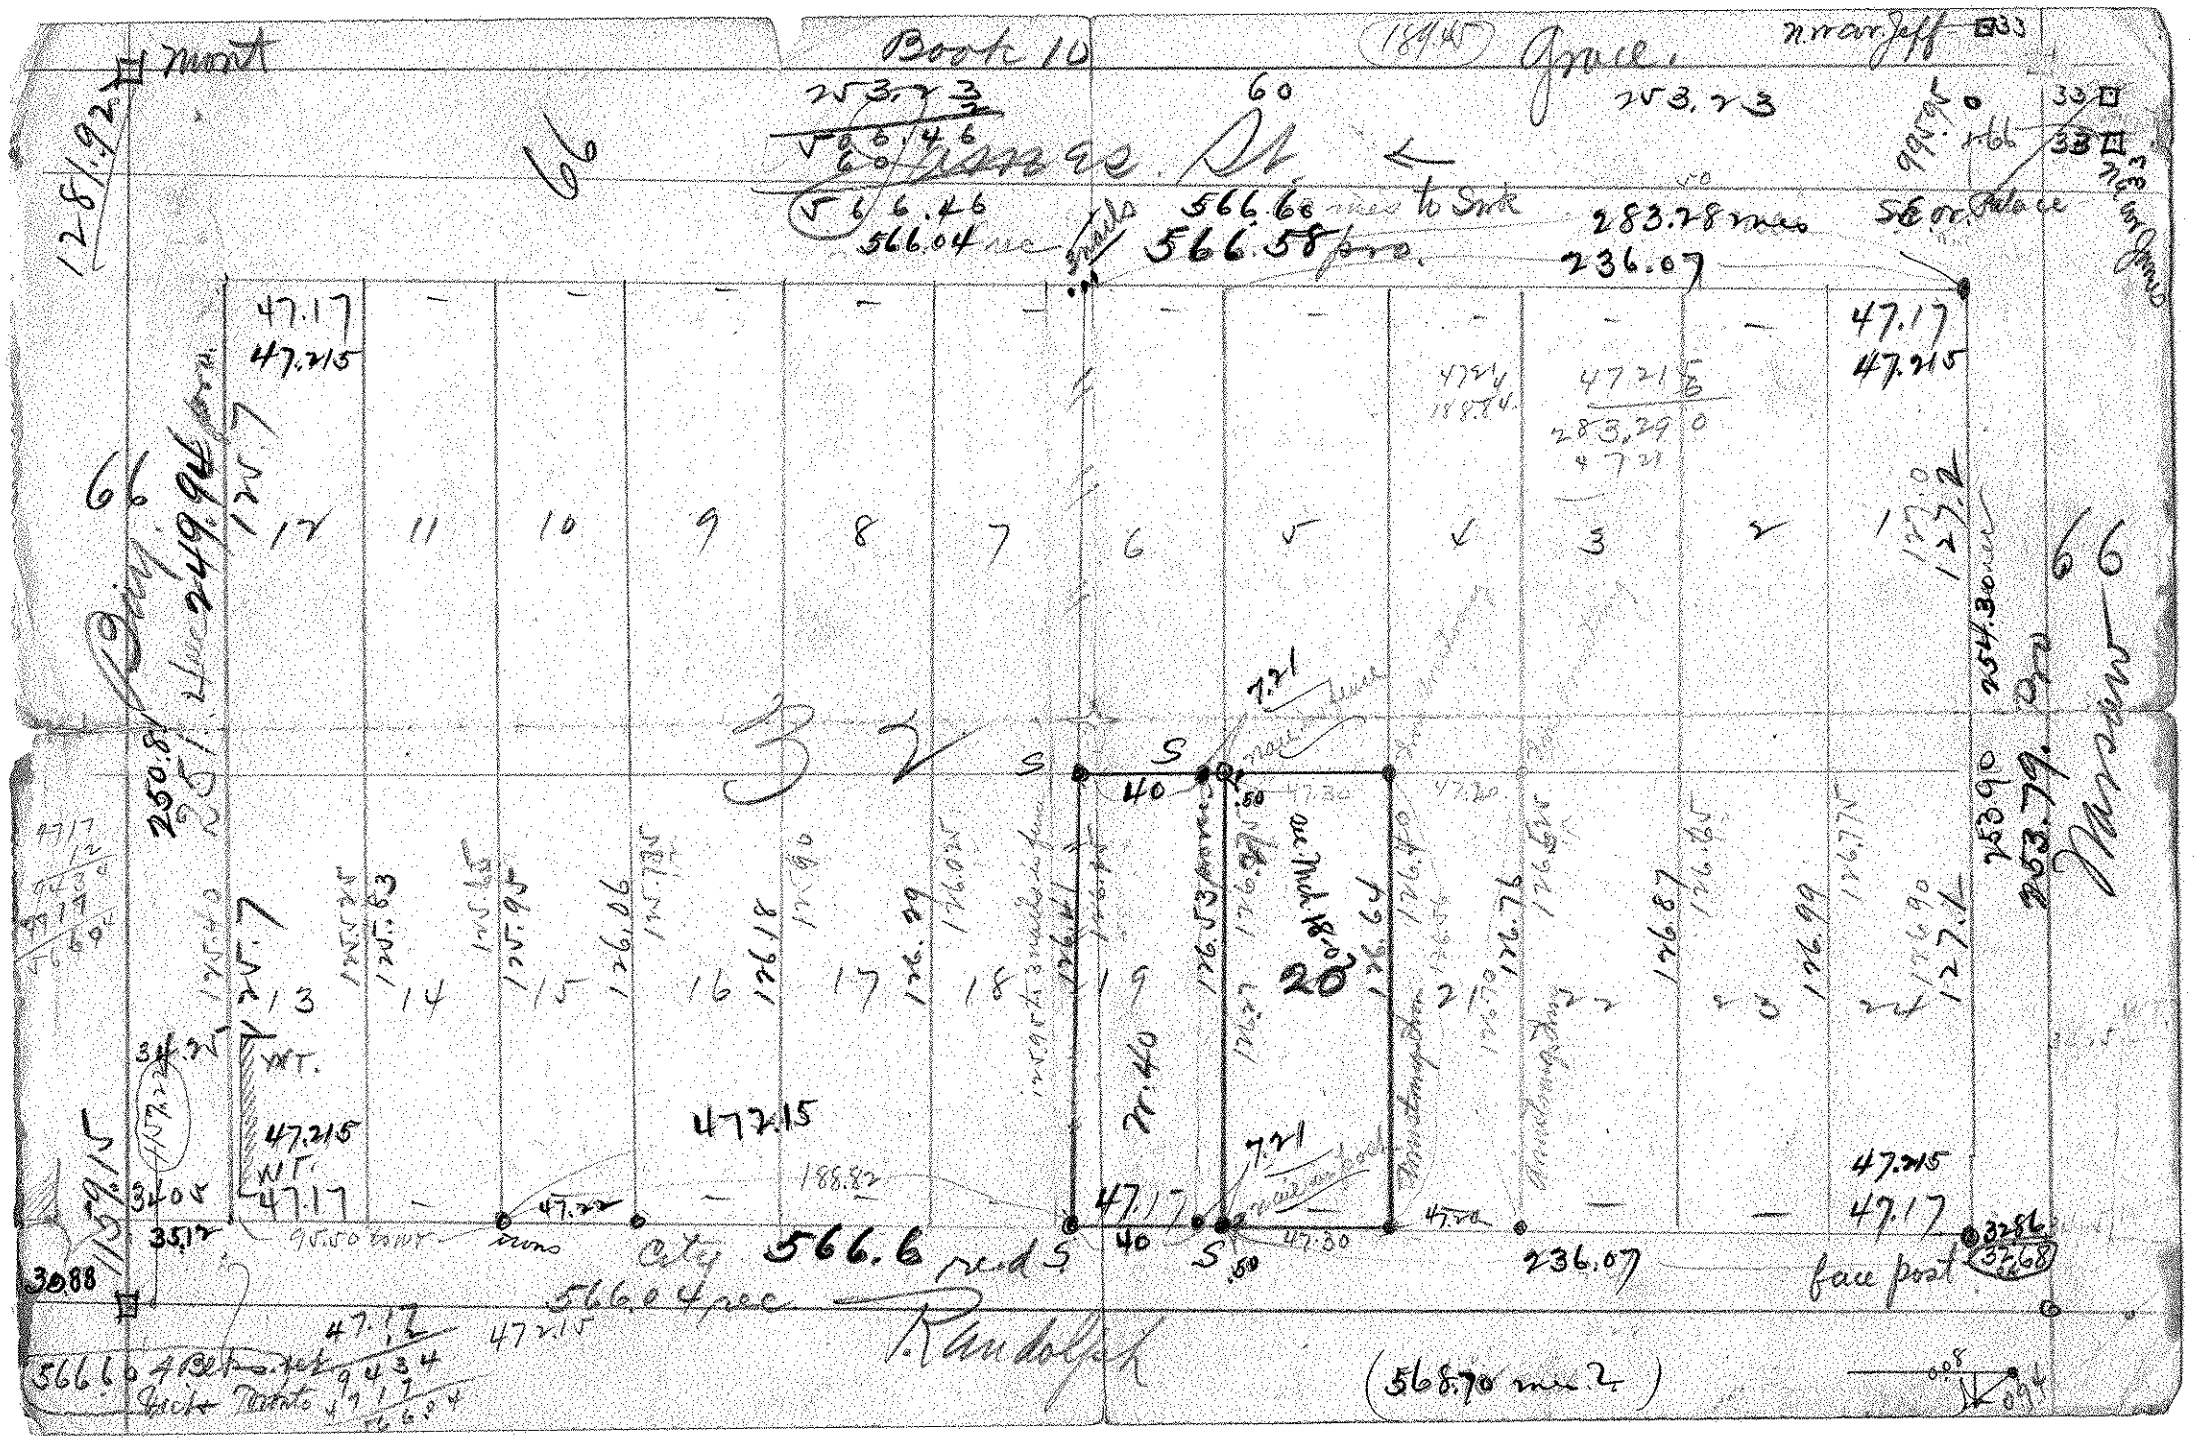

Book 10
(1845) Grace.
Mont
66
253.23
566.46
566.04 rec
566.60 mes to Sink
566.58 pro.
283.28 mes
236.07
47.17
47.215
12
11
10
9
8
7
6
5
4
3
2
1
66
32
S
40
20
47.215
47.17
566.6 red S
566.04 rec
Randolph
(568.70 mes 2)
face post