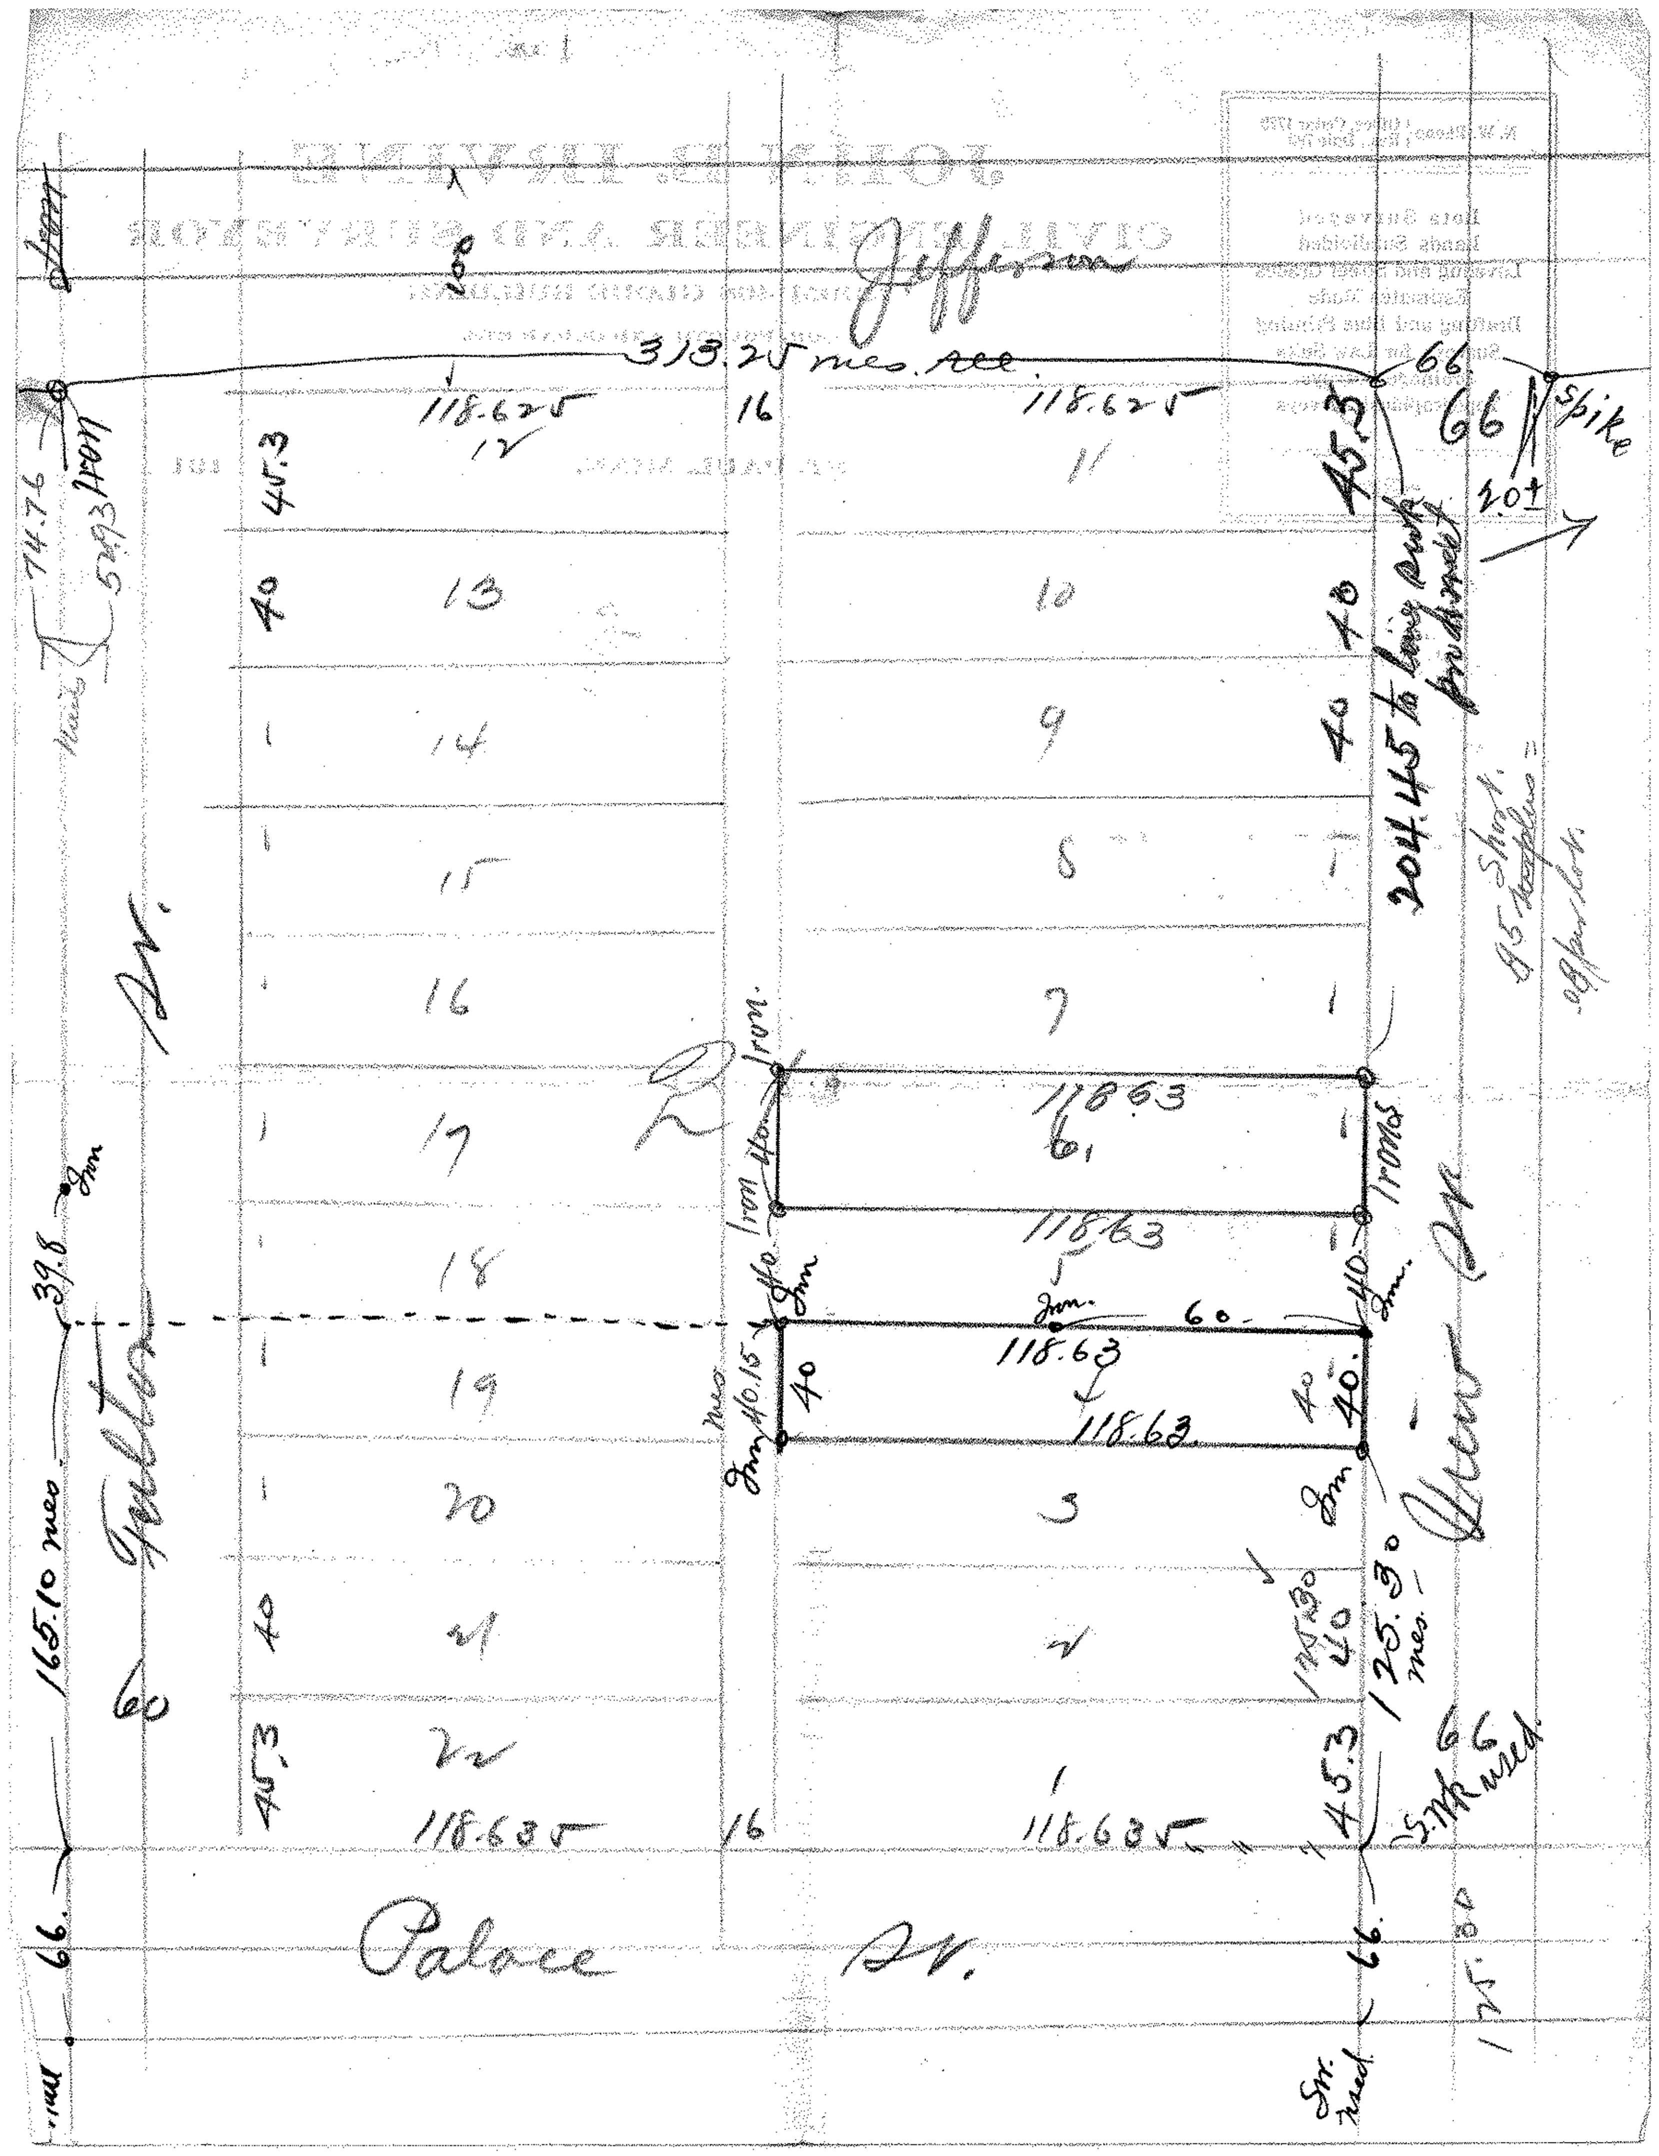
Jefferson
313.25 mes. acc.
118.625
16
66
Spike
45.3
40
12
11
13
10
14
9
15
8
16
7
17
6
18
5
19
4
20
3
21
2
22
1
118.63
Iron
40.15 mes
60.
39.8
165.10 mes
Fulton Av.
125.30 mes.
S.Mk used
118.635
66.
Palace Av.