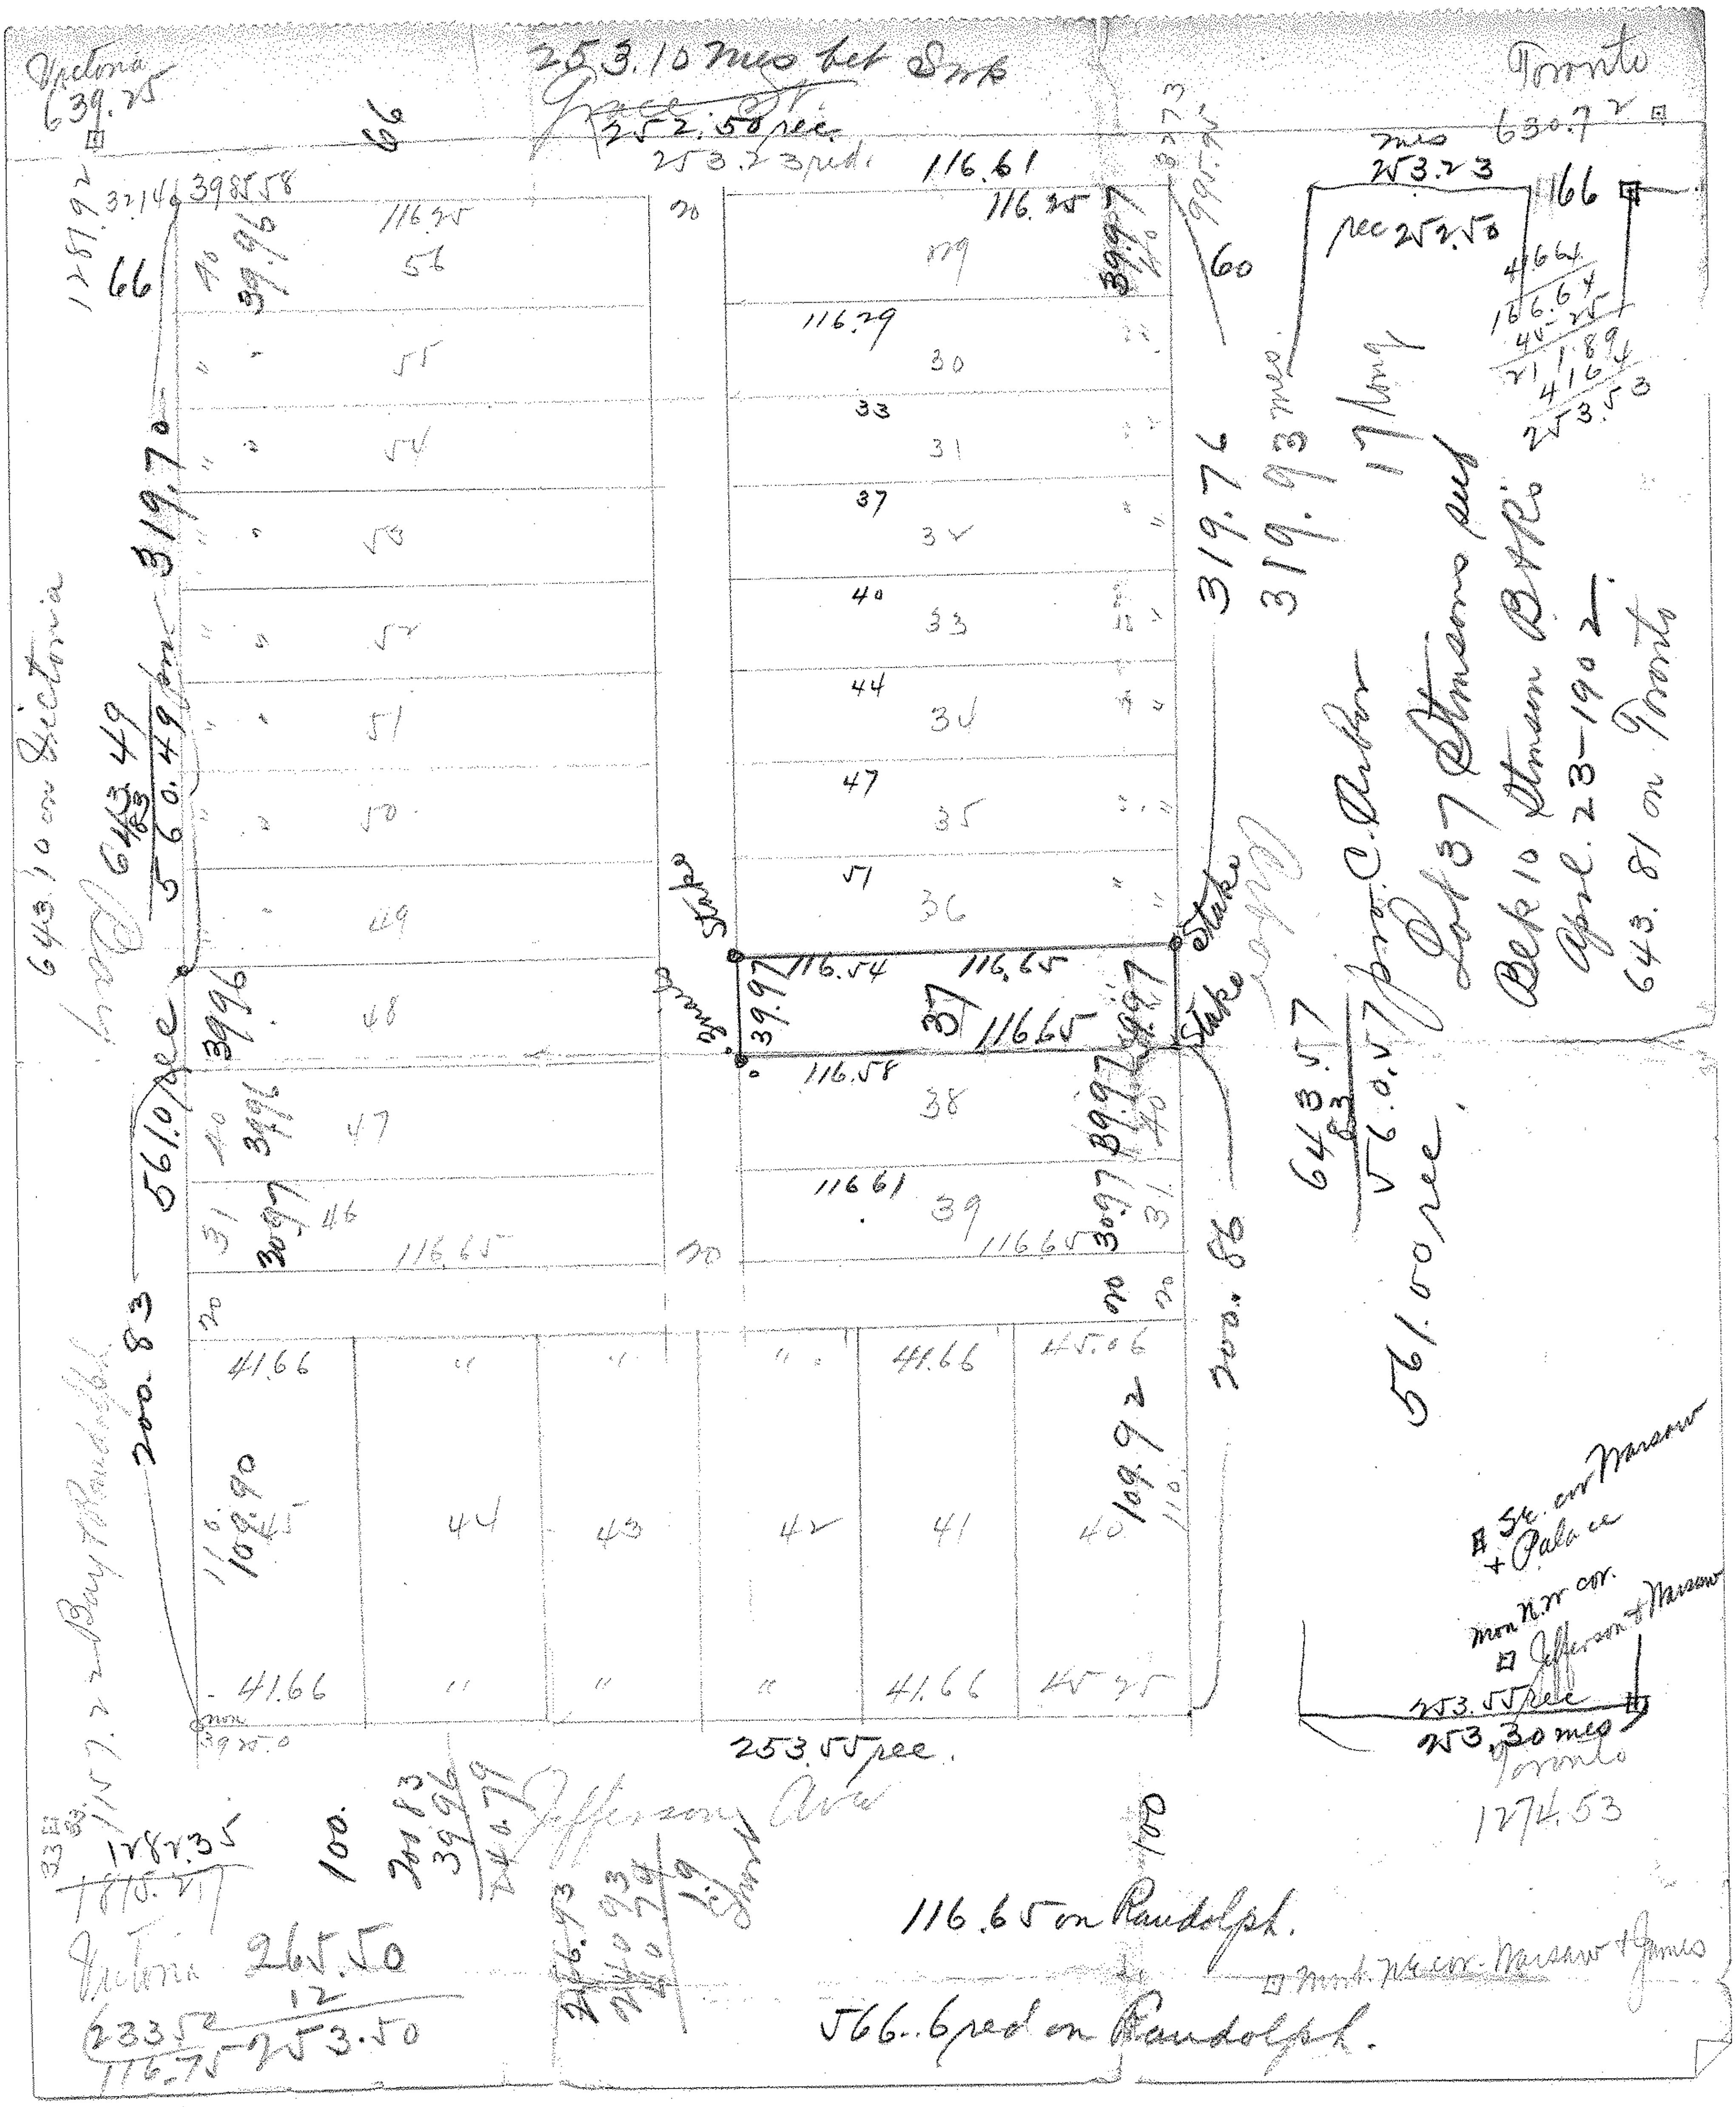
Victoria 639.25
253.10 mes bet Smk
252.50 rec
253.23 ped
Toronto 630.72
mes 253.23
rec 252.50
166
4.664
166.64
45.25
211.89
41.64
253.50
60
66
1287.92
66
319.70
319.76
319.93 mes
11 Aug
643.10 on Victoria
643.49
560.49
561.0 rec
Stake
Stake
Stake
37
116.54
116.65
116.65
116.58
116.61
116.65
39.97
Lot 37 Stimsons sub
Blk 10 Stimsons Bros
Proj. C. Aubon
Apr. 23 - 1902
643.81 on Toronto
643.57
83
560.57
561.00 rec
200.83
200.86
109.92
41.66
45.06
45.25
44
43
42
41
40
Sk. cor Warsaw + Palace
mon N.W. cor. Jefferson + Warsaw
253.55 rec
253.30 mes
Toronto 1274.53
253.55 rec
Jefferson Ave
116.65 on Randolph
566.6 ped on Randolph
Mon. N.E. cor. Warsaw + James
1287.35
1818.27
Victoria 265.50
12
233.50
116.75
253.50
100
100