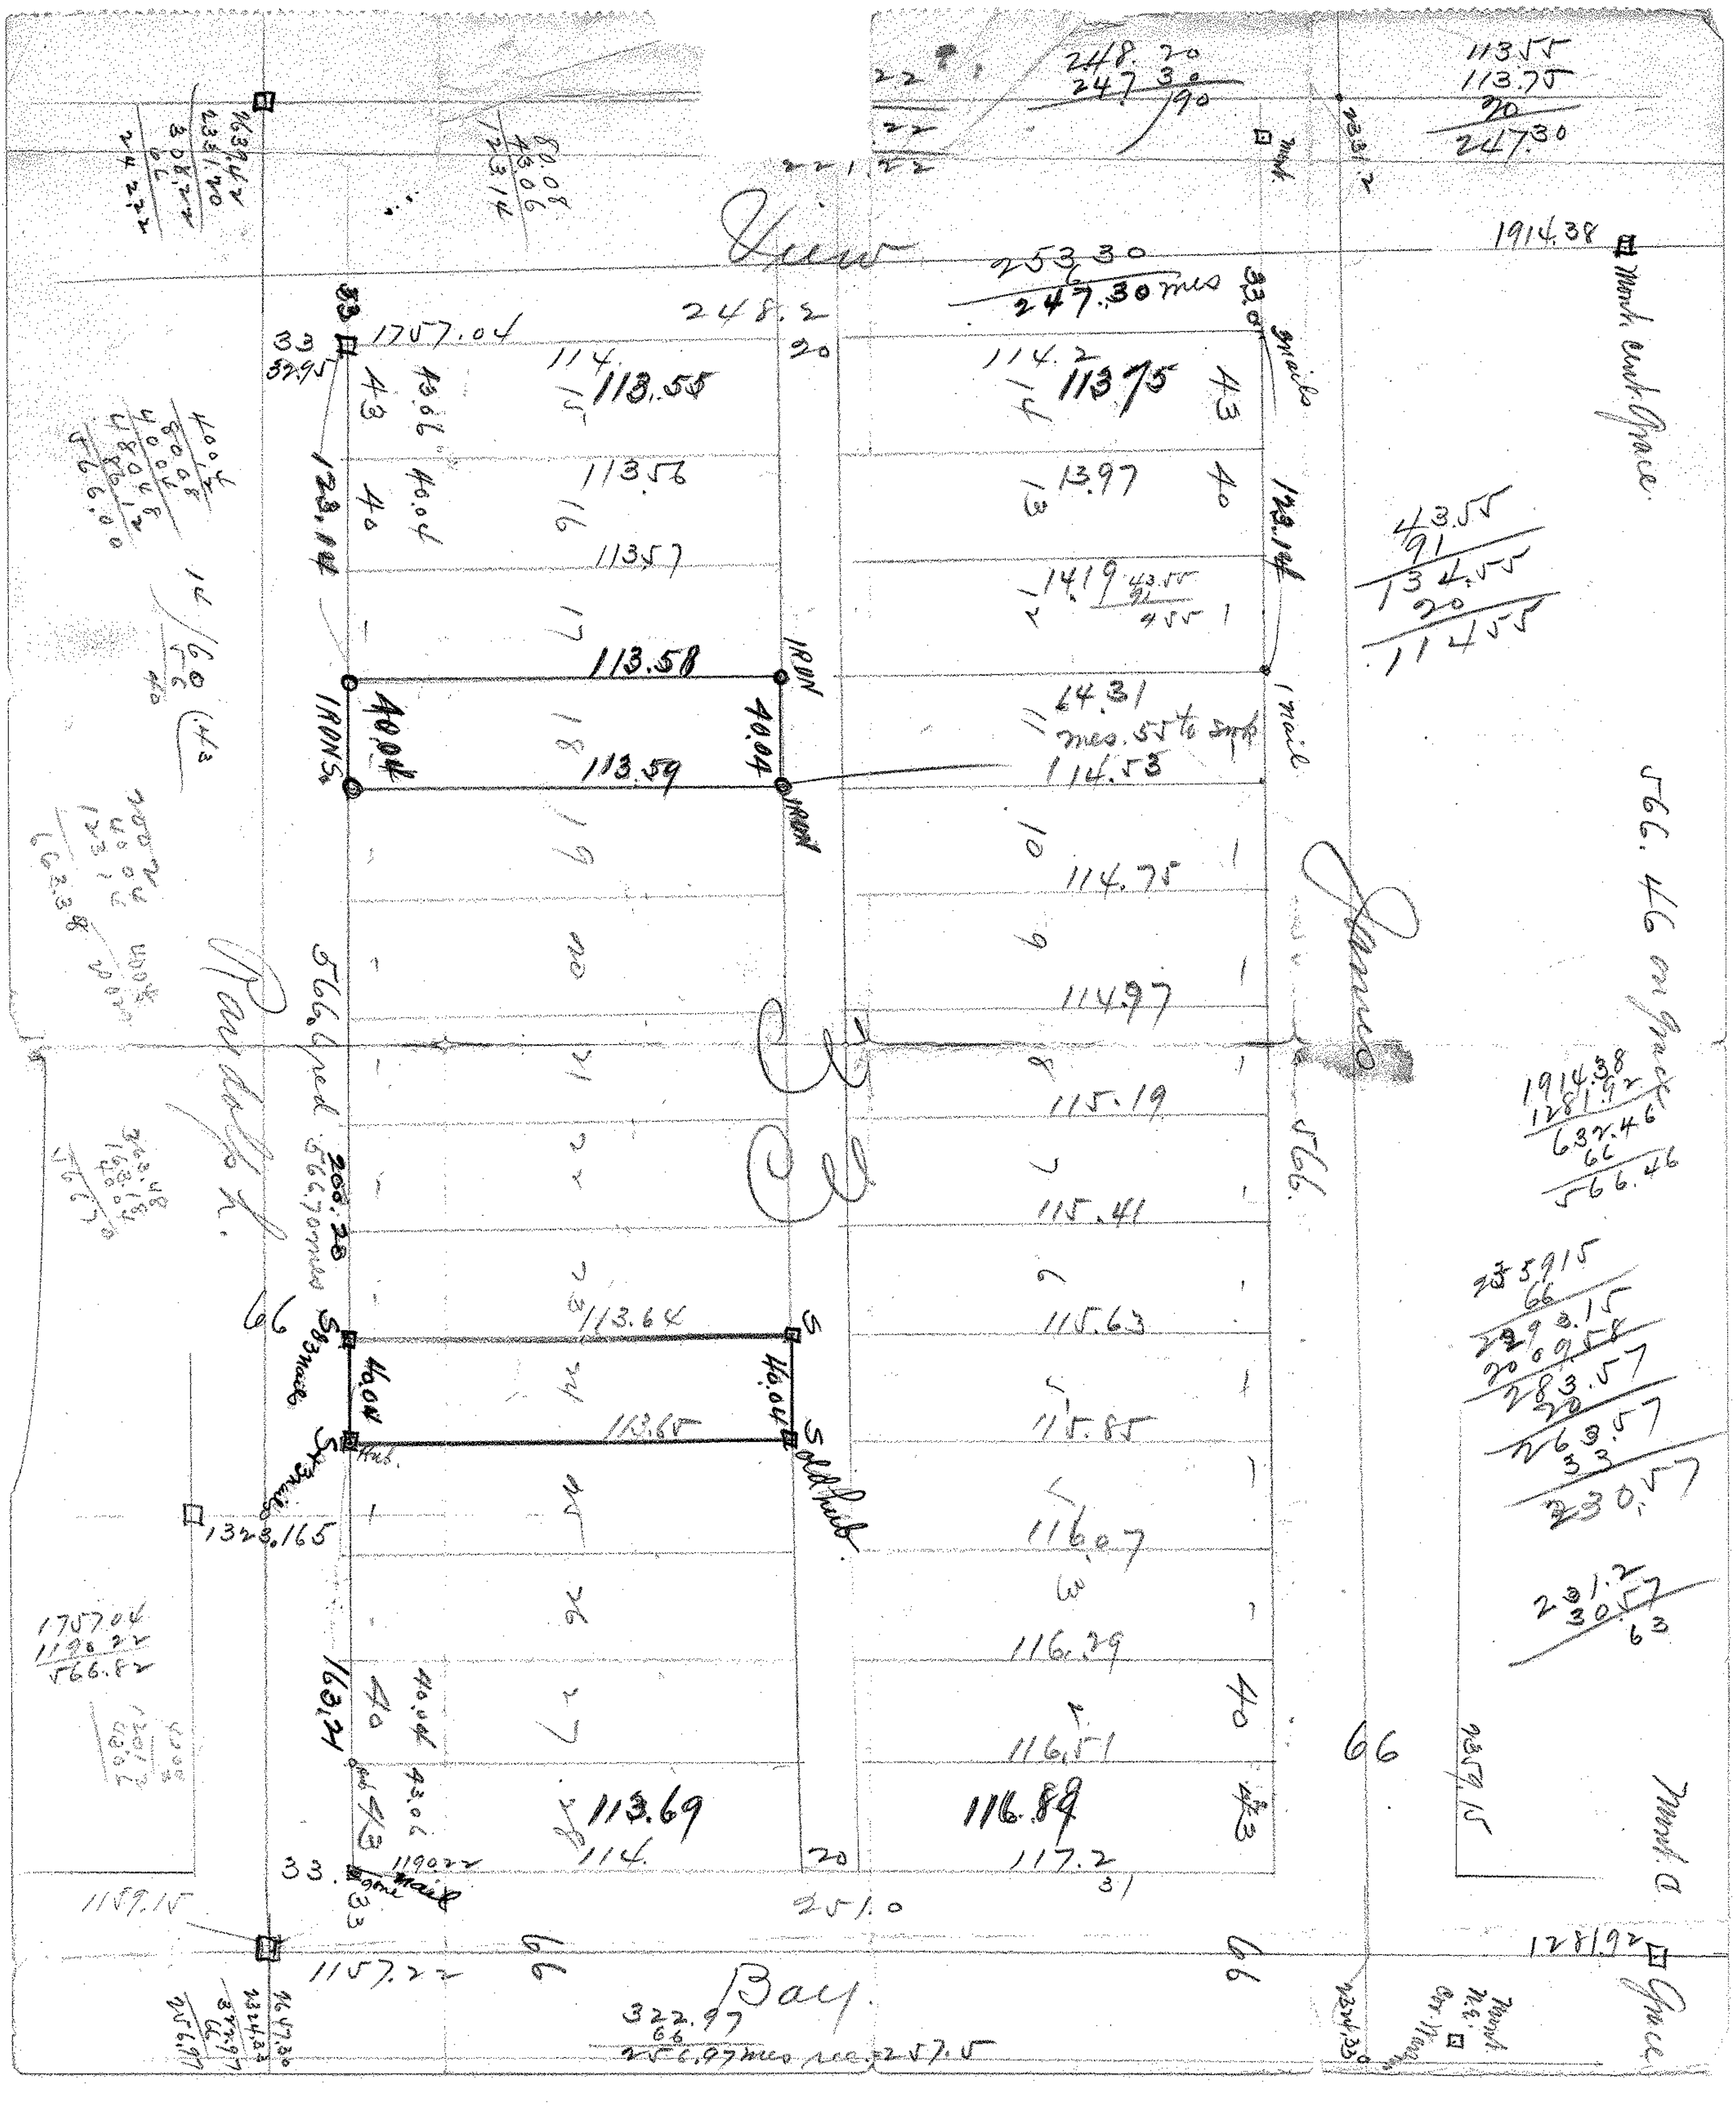
View
Bay
James
Randolph
Grace
33
248.2
253.30
247.30 mes
1914.38
Mark outside Grace
1757.04
113.55
113.56
113.57
113.58
113.59
113.64
113.65
113.69
113.75
13.97
1419
64.31
mes. 55 to sup
114.53
114.75
114.97
115.19
115.41
115.63
115.85
116.07
116.29
116.51
116.89
117.2
Irons
Iron
40.04
123.14
163.24
566 pred 566.70 mes
566.
566.46 on Grace
1914.38
1281.92
632.46
66
566.46
1323.165
Old hub
Nail
1157.22
1159.15
251.0
322.97
66
256.97 mes rec. 257.5
1281.92
1757.04
1190.22
566.82