


WEST 103ft. LOTS 16 & 17 BLOCK 39  
A.V. BROWN'S SUB of S. B. & R. ADD.  
AND WEST 103ft. LOT 2 BLOCK 1.  
SUMMIT TERRACE ADD. NO. 2.

JOHN B. IRVINE. SURVEYOR.  
ST. PAUL MINN.  
SEPT. 16-08.  
SCALE 20 ft. per inch.

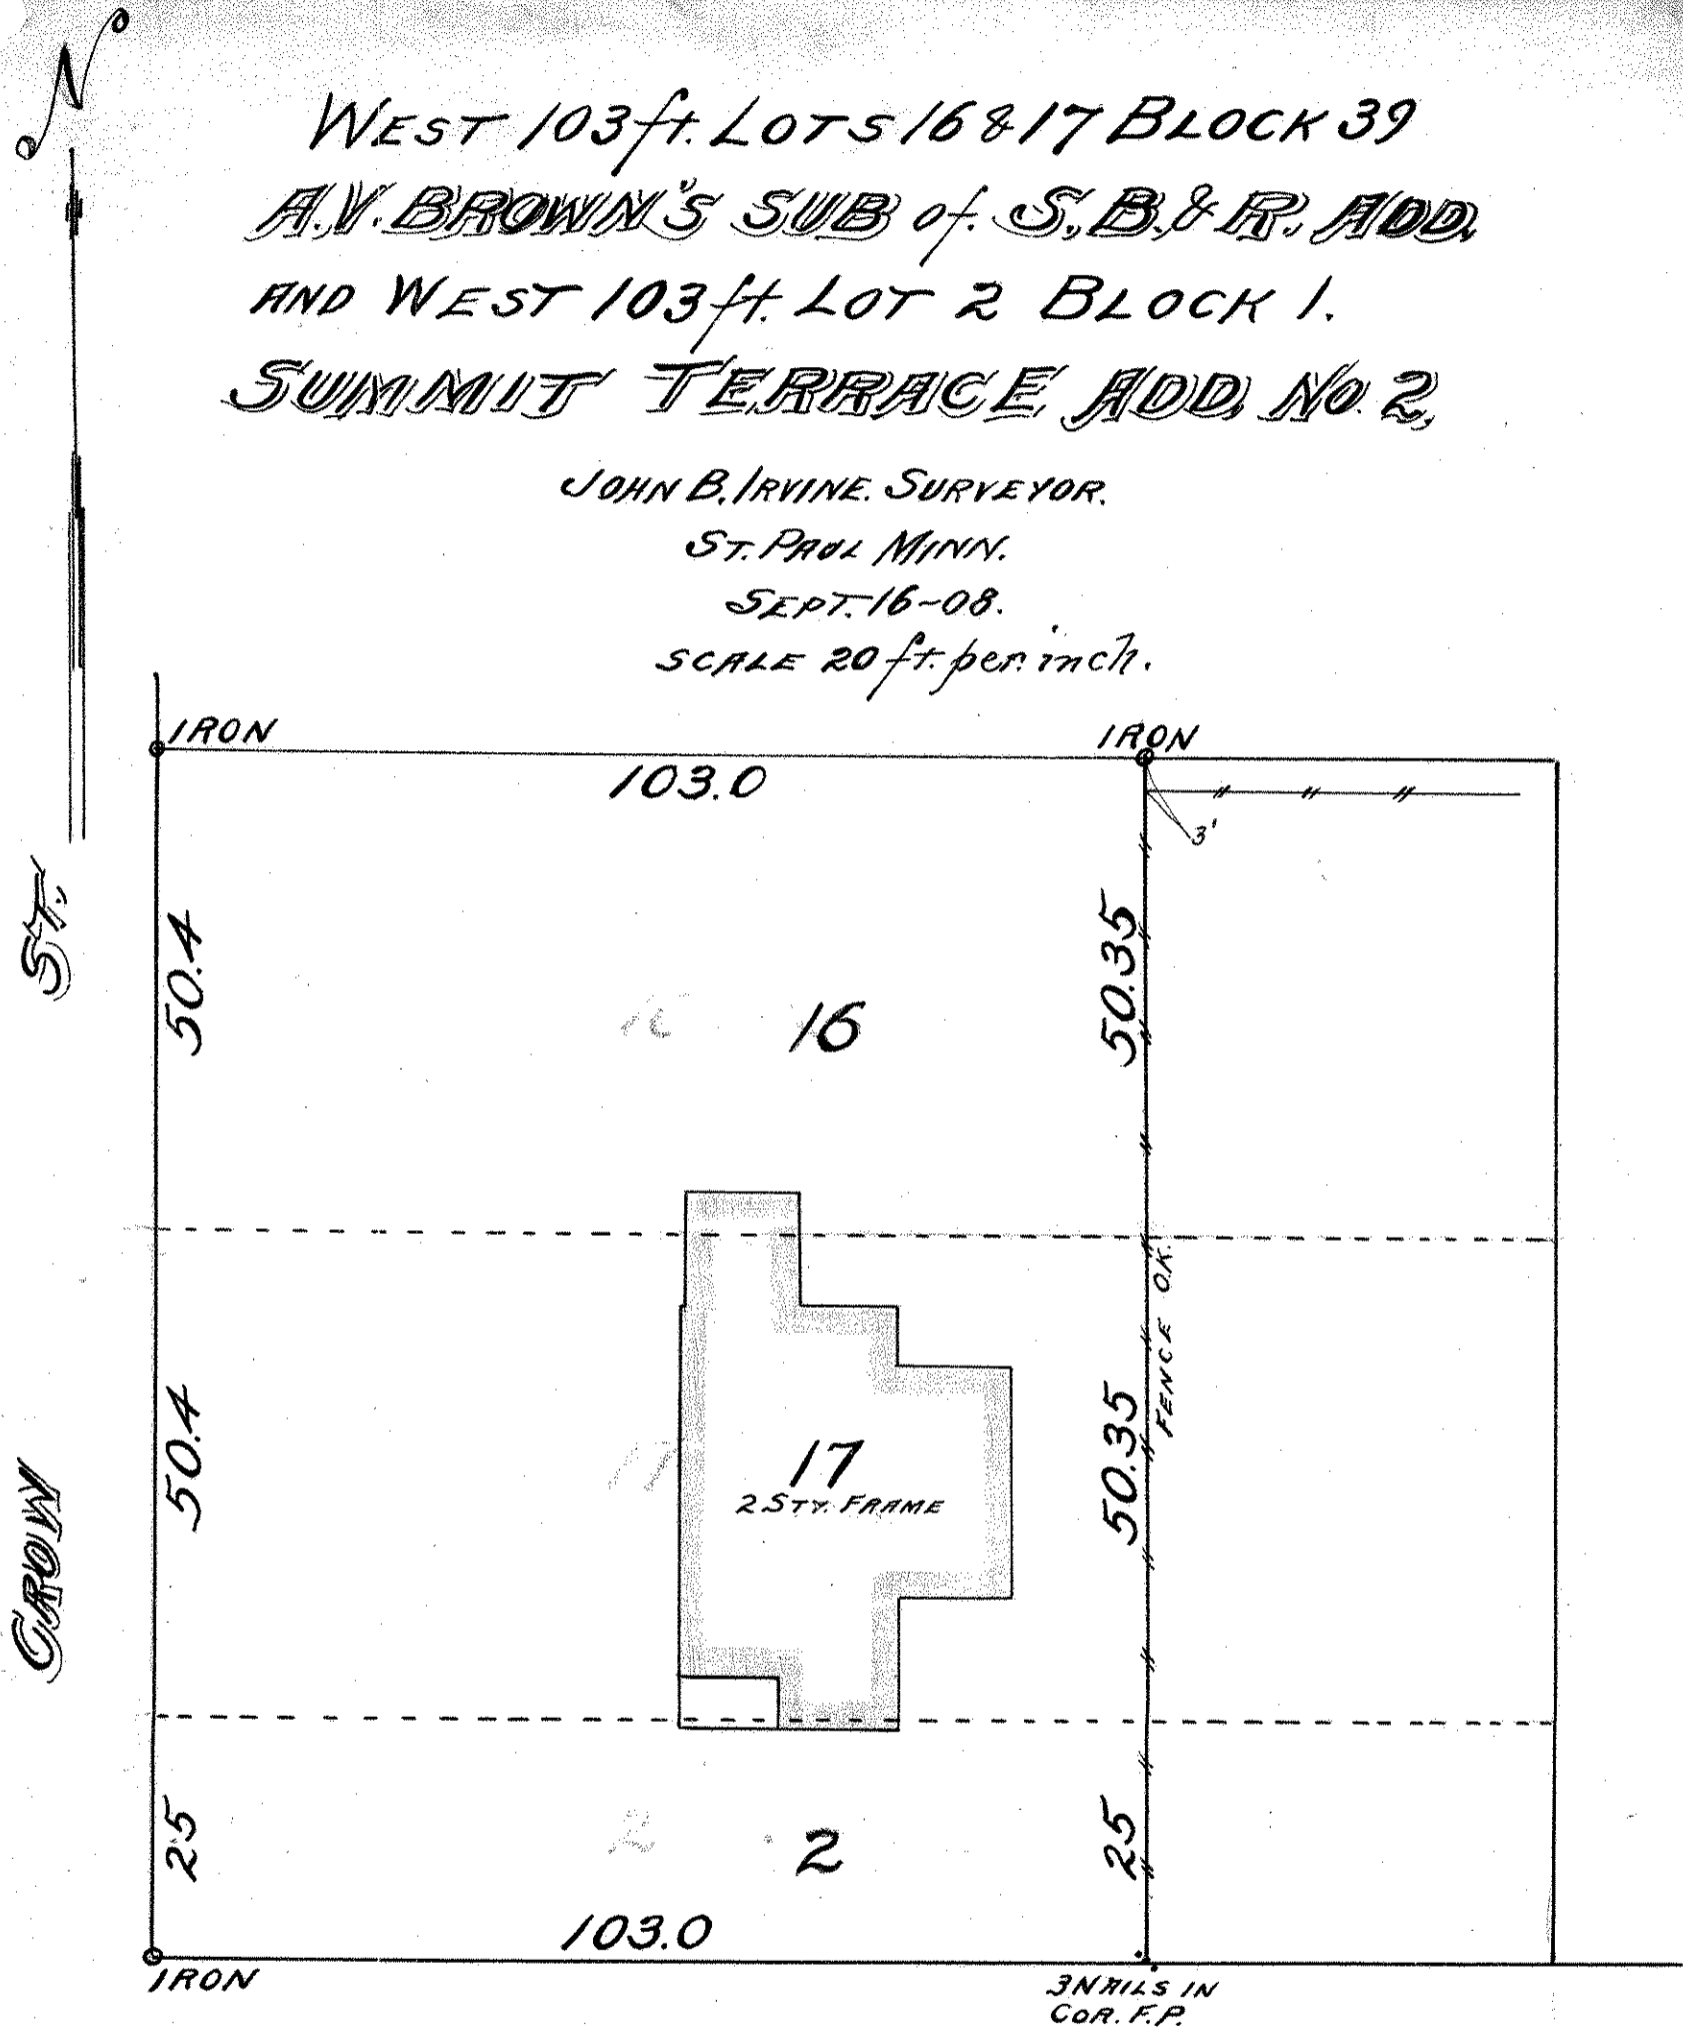

SUMMIT TERRACE.